USE TYPEWRITER OR BALL POINT PEN-PRESS FIRMLY, PRINT CLEARLY.

WATER WELL RECORD
KSA 82a-1201-1215

Kansas Department of Health and Environment-Division of Environment
(Water well Contractors)
Topeka, Kansas 66620

1. Location of well: County: Kiowa | Fraction: NE 1/4 NW 1/4 NW 1/4 | Section number: 3 | Township number: T 29 S | Range number: R 19 (W)

2. Distance and direction from nearest town or city: 4E 25 Mullinville
Street address of well location if in city: Kansas

3. Owner of well: Harold Schmidt
R.R. or street:
City, state, zip code: Greensburg Kansas

4. Locate with "X" in section below:

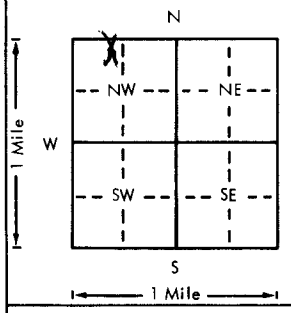


Sketch map:

6. Bore hole dia. 8 3/4 in. Completion date 6-25-75
Well depth 160 ft.

7. Cable tool X Rotary Driven Dug
Hollow rod Jetted Bored Reverse rotary

8. Use: Domestic Public supply Industry
Irrigation Air conditioning X Stock
Lawn Oil field water Other

9. Casing: Material PL Height: Above or below
Threaded Welded GI Surface 12 in.
RMP X PVC Weight lbs./ft.
Dia. 5 in. to 160 ft. depth Wall Thickness: inches or
Dia. in. to ft. depth gage No. 200

| 5. Type and color of material | From | To |
|---|---|---|
| Top Soil | 0 | 3 |
| Lt. BR. Clay | 3 | 46 |
| Gravel (DRY To 122) | 46 | 160 |

10. Screen: Manufacturer's name Sunflower Plastics
Type RMP Dia. 5
Slot/gauze 1/8 Length 20
Set between 140 ft. and 160 ft.
ft. and ft.
Gravel pack? X Size range of material 1/8 x 1/2

11. Static water level: mo./day/yr.
122 ft. below land surface Date 6-15-75

12. Pumping level below land surfaces:
122 ft. after 1 hrs. pumping 10 g.p.m.
ft. after hrs. pumping g.p.m.
Estimated maximum yield 25 g.p.m.

13. Water sample submitted: mo./day/yr.
Yes X No Date

14. Well head completion:
Pitless adapter 12 Inches above grade

15. Well grouted? X
With: X Neat cement Bentonite Concrete
Depth: From 0 ft. to 10 ft.

16. Nearest source of possible contamination:
ft. 25 Direction S Type Cattle
Well disinfected upon completion? Yes X No

17. Pump: Not installed
Manufacturer's name Flint & Walling
Model number JB412 HP 3/4 Volts 230
Length of drop pipe 147 ft. capacity 10 g.p.m.
Type:
X Submersible Turbine
Jet Reciprocating
Centrifugal Other

(Use a second sheet if needed)

18. Elevation:

Topography:
Hill
Slope
X Upland
Valley

19. Remarks:

20. Water well contractor's certification:
This well was drilled under my jurisdiction and this report is true to the best of my knowledge and belief.
Carl Hayes Water Well Serv. License No. 224
Business name
Address 603 S. Maple Greensburg Kan.
Signed Carl Hayes Date 6-15-75
Authorized representative

T 29 R 19 (W) Sec 3 NE 1/4 1/4 1/4

Forward the white, blue and pink copies to the Department of Health and Environment

Form WWC-5

MI-1023