USE TYPEWRITER OR BALL POINT PEN-PRESS FIRMLY, PRINT CLEARLY.

WATER WELL RECORD
KSA 82a-1201-1215

Kansas Department of Health and Environment-Division of Environment
(Water well Contractors)
Topeka, Kansas 66620

1. Location of well:	County	Fraction	Section number	Township number	Range number
	Kiowa	SE 1/4 NE 1/4 1/4	22	T 29 S	R 19 E/W

2. Distance and direction from nearest town or city:
3W 6S of Greensburg
Street address of well location if in city:

3. Owner of well: Lavern Miller
R.R. or street: Rt.2
City, state, zip code: Greemsburg, Ks.

4. Locate with "X" in section below:

Sketch map:

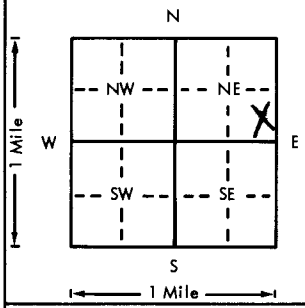

6. Bore hole dia. 29 in. Completion date 7-6-76
Well depth 223 ft.

7. ___ Cable tool X Rotary ___ Driven ___ Dug
___ Hollow rod ___ Jetted ___ Bored ___ Reverse rotary

8. Use: ___ Domestic ___ Public supply ___ Industry
X Irrigation ___ Air conditioning ___ Stock
___ Lawn ___ Oil field water ___ Other

9. Casing: Material steel Height: Above or ~~below~~
Threaded ___ Welded X Surface 18 in.
RMP ___ PVC ___ Weight ___ lbs./ft.
Dia. 16 in. to 223 ft. depth Wall Thickness: inches or
Dia. ___ in. to ___ ft. depth gage No. 7

5. Type and color of material	From	To
Top Soil	0	2
Brown and White Clay, Little rocks in it	2	150
Gray, Brown, & White Clay	150	177
Sand and Gravel clean coarse loose	177	223
Brown Clay and Rock	223	230
Yellow Brown Light Gray Clay	230	245

(Use a second sheet if needed)

10. Screen: Manufacturer's name Doerrs
Type Steel Dia. 16
Slot/~~gauze~~ 3/16 Length 40
Set between 183 ft. and 223 ft.
___ ft. and ___ ft.
Gravel pack? X Size range of material 1/2 3/4 3/8

11. Static water level:
158 ft. below land surface Date 3-17-76 mo./day/yr.

12. Pumping level below land surfaces:
171 ft. after 2 hrs. pumping 700 g.p.m.
___ ft. after ___ hrs. pumping ___ g.p.m.
Estimated maximum yield 900 g.p.m.

13. Water sample submitted: mo./day/yr.
___ Yes X No Date

14. Well head completion:
___ Pitless adapter ___ Inches above grade

15. Well grouted? X
With: ___ Neat cement ___ Bentonite ✓ MHC Concrete
Depth: From 0 ft. to 12 ft.

16. Nearest source of possible contamination:
ft. 150' Direction W Type Correll
Well disinfected upon completion? ___ Yes ___ No

17. Pump: W. ~~L.~~ R. Not installed
Manufacturer's name
Model number 8CM12 HP 100 Volts
Length of drop pipe 210 ft. capacity 900 g.p.m.
Type:
___ Submersible X Turbine
___ Jet ___ Reciprocating
___ Centrifugal ___ Other

18. Elevation:

Topography:
___ Hill
___ Slope
X Upland
___ Valley

19. Remarks:

20. Water well contractor's certification:
This well was drilled under my jurisdiction and this report is true to the best of my knowledge and belief.
Rosencrantz-Bemis, 134
Business name License No.
Address Great Bend, Ks.
Signed Fredia Dodson Date 12/10/76
Authorized representative

T 29 R 19 W Sec 22 1/4 1/4 1/4 SE SE NE

Forward the white, blue and pink copies to the Department of Health and Environment

Form WWC-5

MI-1023