

318


WATER WELL RECORD Form WWC-5 KSA 82a-1212

1 LOCATION OF WATER WELL: Fraction Section Number Township Number Range Number
COUNTY: KIOWA NE 1/4 NW 1/4 NE 1/4 32 T 29 S R 19 W

Distance and direction from nearest town or city street address of well if located within city?
3.5 MILES EAST, 7 MILES SOUTH OF MULLINVILLE

2 WATER WELL OWNER: EDMONSTON, DONALD Board of Agriculture, Division of Water Resources
RR#, St. Address, Box #: Greensburg, KS 67054- Application Number:

3 LOCATE WELL'S LOCATION WITH AN "X" IN SECTION BOX:

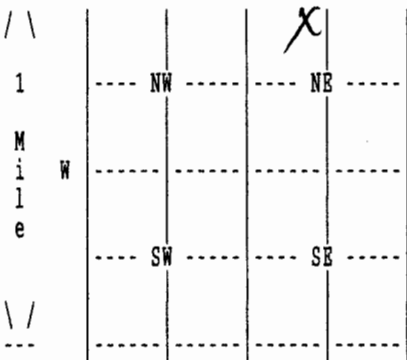

4 DEPTH OF COMPLETED WELL 240 ELEVATION: 0
Depth(s) Groundwater Encountered 1. 0 ft. 2. 0 ft. 3. 0 ft.

WELL'S STATIC WATER LEVEL 200 ft. below land surface measured on mo/day/yr 05/17/08
Pump test data: Well water was 0 ft. after 0 hours pumping 0 gpm
Estimated Yield 0 gpm: Well water was 0 ft. after 0 hours pumping 0 gpm
Bore Hole Diameter 9.875 in. to 240 ft., and in. to 0 ft.
WELL WATER TO BE USED AS: LIVESTOCK
Was a chemical/bacteriological sample submitted to department? No ;
If yes, mo/day/yr sample was submitted Water well disinfected? Yes

5 TYPE OF BLANK CASING USED: PVC CASING JOINTS: GLOUED
Blank casing diameter 5 in. to 220 ft., Dia in. to 0 ft., Dia in. to 0 ft.
Casing height above land surface 18 in., weight 0 lbs/ft. Wall thickness or gauge No. 21
TYPE OF SCREEN OR PERFORATION MATERIAL: PVC
SCREEN OR PERFORATION OPENINGS ARE: SAW CUT

SCREEN PERFORATED INTERVALS: From 220 ft. to 240 ft., From 0 ft. to 0 ft.
From 0 ft. to 0 ft., From 0 ft. to 0 ft.
GRAVEL PACK INTERVALS: From 25 ft. to 240 ft., From 0 ft. to 0 ft.
From 0 ft. to 0 ft., From 0 ft. to 0 ft.

6 GROUT MATERIAL BENTONITE
Grout Intervals: From 4 ft. to 25 ft., From 0 ft. to 0 ft., From 0 ft. to 0 ft.
What is the nearest source of possible contamination: SEPTIC TANK
Direction from well? EAST How many feet? 7000

FROM	TO	LITHOLOGIC LOG	FROM	TO	PLUGGING INTERVALS
0	203	TAN CLAY			
203	208	SAND			
208	229	TAN CLAY			
229	235	SAND AND GRAVEL			
235	240	GRAY SHALE			

7 CONTRACTOR'S OR LANDOWNER'S CERTIFICATION: This water well was Constructed under my jurisdiction and was completed on (mo/day/year) 05/17/08 and this record is true to the best of my knowledge and belief. Kansas Water Well Contractor's License No. 653 This Water Well Record was completed on (mo/day/yr) 06/17/08 under the business name of DAN HAYSE WATER WELL SERV by (signature) Dan Hayse