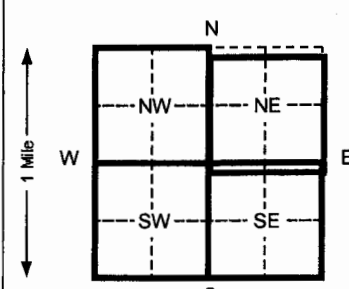


1 LOCATION OF WATER WELL:		Fraction		Section Number		Township Number		Range Number	
County: Sedgwick		NE ¼ NE ¼ NW ¼		26		T 29 S		R 2 W	
Distance and direction from nearest town or city street address of well if located within city? 101 W. Ross, Clearwater, Kansas									
2 WATER WELL OWNER: Seward Estate c/o KDHE Time and Materials									
RR#, St. Address, Box # : 1000 SW Jackson #410 Board of Agriculture, Division of Water Resources									
City, State, ZIP Code : Topeka, Ks 66612-1367 Application Number:									
3 LOCATE WELL'S LOCATION WITH AN "X" IN SECTION BOX:		4 DEPTH OF COMPLETED WELL 20.5 ft. ELEVATION:							
		Depth(s) Groundwater Encountered 1 16 ft. 2 _____ ft. 3 _____ ft.							
		WELL'S STATIC WATER LEVEL 15.68 ft. below land surface measured on mo/day/yr 06/23/04							
		Pump test data: Well water was _____ Ft. after _____ hours pumping _____ Gpm							
		Est. Yield _____ Gpm: Well water was _____ Ft. after _____ Hours pumping _____ Gpm							
		Bore Hole Diameter 8.625 In. to 20.5 Ft. and _____ in. to _____ Ft.							
		WELL WATER TO BE USED AS: 5 Public water supply 8 Air conditioning 11 Injection well							
		1 Domestic 3 Feed lot 6 Oil field water supply 9 Dewatering 12 Other (Specify below)							
		2 Irrigation 4 Industrial 7 Lawn and garden (domestic) 10 Monitoring well MW-5							
		Was a chemical/bacteriological sample submitted to Department? Yes _____ No X If yes, mo/day/yr sample was Submitted _____							
		Water Well Disinfected? Yes _____ No X							
5 TYPE OF BLANK CASING USED:									
1 Steel 3 RMP (SR) 5 Wrought Iron 8 Concrete tile CASING JOINTS: Glued _____ Clamped _____									
2 PVC 4 ABS 6 Asbestos-Cement 9 Other (specify below) _____ Welded _____									
7 Fiberglass _____ Threaded X									
Blank casing diameter 2 In. to 10.5 Ft., Dia _____ In. to _____ ft., Dia _____ in. to _____ ft.									
Casing height above land surface FLUSH in., weight SCH 40 Lbs./ft. Wall thickness or gauge No. _____									
TYPE OF SCREEN OR PERFORATION MATERIAL:									
1 Steel 3 Stainless steel 5 Fiberglass 8 RMP (SR) 11 Other (specify) _____									
2 Brass 4 Galvanized steel 6 Concrete tile 9 ABS 12 None used (open hole)									
SCREEN OR PERFORATION OPENINGS ARE:									
1 Continuous slot 3 Mill slot 5 Gauzed wrapped 8 Saw cut 11 None (open hole)									
2 Louvered shutter 4 Key punched 6 Wire wrapped 9 Drilled holes									
3 _____ 7 Torch cut 10 Other (specify) _____									
SCREEN-PERFORATED INTERVALS: From 10.5 ft. to 20.5 ft. From _____ ft. to _____ ft.									
SAND PACK INTERVALS: From 8.5 ft. to 20.5 ft. From _____ ft. to _____ ft.									
6 GROUT MATERIAL:									
1 Neat cement 2 Cement grout 3 Bentonite 4 Other _____									
Grout Intervals From 3 0 ft. to 6.5 Ft. From 2 6.5 to 8.5 ft. From _____ ft. to _____ ft.									
What is the nearest source of possible contamination:									
1 Septic tank 4 Lateral lines 7 Pit privy 10 Livestock pens 14 Abandoned water well									
2 Sewer lines 5 Cess pool 8 Sewage lagoon 11 Fuel storage 15 Oil well/ Gas well									
3 Watertight sewer lines 6 Seepage pit 9 Feedyard 12 Fertilizer storage 16 Other (specify below) Contaminated Site									
Direction from well? _____ How many feet? _____									
FROM TO CODE LITHOLOGIC LOG FROM TO PLUGGING INTERVALS									
0 8" Gravel									
8" 16 Clayey Silt (ML)									
16 20.5 Silty Sand (SM)									
20.5 TD End of borehole									
7 CONTRACTOR'S OR LANDOWNER'S CERTIFICATION: This water well was (x) constructed, (2) reconstructed, or (3) plugged under my jurisdiction and									
Completed on (mo/day/yr) 06/23/04 And this record is true to the best of my knowledge and belief. Kansas									
Water Well Contractor's License No. 585 This Water Well Record was completed on (mo/day/yr) 07/01/04									
under the business name of Associated Environmental, Inc. By (signature) Darin R Duncan									
INSTRUCTIONS: Please fill in blanks and circle the correct answers. Send three copies to Kansas Department of Health and Environment, Bureau of Water, Topeka, Kansas 66620-0001. Telephone: 913-296-5545. Send one to WATER WELL OWNER and retain one for your records.									