


South side of 95th St. S., approximately ½ mile west of 183rd St. W. – Clearwater

Board of Agriculture, Division of Water Resources

Application Number:

4 DEPTH OF COMPLETED WELL 16.5 ft. ELEVATION: 1282.82 (TOC)

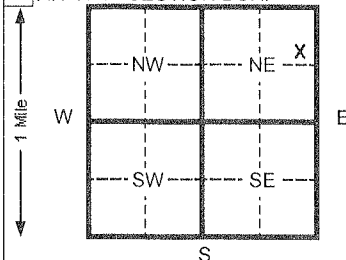

Depth(s) Groundwater Encountered 1 4 ft. 2 _____ ft. 3 _____ ft.

WELL'S STATIC WATER LEVEL _____ ft. below land surface measured on mo/day/yr _____

Pump test data: Well water was _____ ft. after _____ hours pumping _____ gpm

Est. Yield	gpm:	Well water was	ft. after	hours pumping	gpm
------------	------	----------------	-----------	---------------	-----

Bore Hole Diameter	8	in. to	16.5	ft. and	in. to	ft.
--------------------	---	--------	------	---------	--------	-----

WELL WATER TO BE USED AS:	5 Public water supply	8 Air conditioning	11 Injection well
---------------------------	-----------------------	--------------------	-------------------

1 Domestic	3 Feed lot	6 Oil field water supply	9 Dewatering	12 Other (Specify below)
------------	------------	--------------------------	--------------	--------------------------

2 Irrigation	4 Industrial	7 Lawn and garden (domestic)	10 Monitoring well
--------------	--------------	------------------------------	--------------------

Was a chemical/bacteriological sample submitted to Department? Yes No **X** If yes, mo/day/yr sample was

Water Well Disinfected? Yes No ☒

5 TYPE OF BLANK CASING USED:

1 Steel	3 RMP (SR)	6 Asbestos-Cement	9 Other (specify below)	Welded	Flush
2 PVC	4 ABS	7 Fiberglass		Threaded	

Blank casing diameter	2	in. to	11.5	ft. Dia		in. to		ft. Dia		in. to		ft.
-----------------------	---	--------	------	---------	--	--------	--	---------	--	--------	--	-----

Casing height above land surface	36	in., weight	0.703	lbs./ft. Wall thickness or gauge No.	SCH. 40
----------------------------------	----	-------------	-------	--------------------------------------	---------

TYPE OF SCREEN OR PERFORATION MATERIAL:

1 Steel	3 Stainless steel	5 Fiberglass	8 RMP (SR)	11 Asbestos cement
2 Brass	4 Galvanized steel	6 Concrete tile	9 ABS	12 Other (specify) _____
				12 None used (open hole)

SCREEN OR PERFORATION OPENINGS ARE:

SCREEN OR PERFORATION OPENINGS ARE:

1 Continuous slot	3 Mill slot	5 Gauzed wrapped	8 Saw cut	11 None (open hole)
2 Louvered shutter	4 Key punched	6 Wire wrapped	9 Drilled holes	
		7 Torch cut	10 Other (specify)	

SCREEN-PERFORATED INTERVALS: From 11.5 ft. to 16.5 ft. From _____ ft. to _____ ft.

From _____ ft. to _____ ft. From _____ ft. to _____ ft.

GRAVEL PACK INTERVALS: From 9 ft. to 16.5 ft. From _____ ft. to _____ ft.

From	ft. to	ft. From	ft. to	ft.

6	GROUT MATERIAL:	1 Neat cement	2 Cement grout	3 Bentonite	4 Other
---	-----------------	---------------	----------------	-------------	---------

Grout Intervals	From	0	ft. to	9	ft. From		ft. to		ft. From		ft. to		ft.
-----------------	------	---	--------	---	----------	--	--------	--	----------	--	--------	--	-----

What is the nearest source of possible contamination:

1 Septic tank	4 Lateral lines	7 Pit privy	10 Insecticide pond	14 Abandoned water well
2 Sewer lines	5 Cess pool	8 Sewage lagoon	11 Fuel storage	15 Oil well/ Gas well
3 Watertight sewer lines	6 Seepage pit	9 Feedyard	12 Fertilizer storage	16 Other (specify below)
			13 Insecticide storage	

Direction from well?

How many feet?

[illegible]

7 CONTRACTOR'S OR LANDOWNER'S CERTIFICATION: This water well was (1) constructed, (2) reconstructed, or (3) plugged under my jurisdiction and was completed on (mo/day/yr) 07/26/11 and this record is true to the best of my knowledge and belief. Kansas

Water Well Contractor's License No. **531** This Water Well Record was completed on (mo/day/yr) **08/11/11**
under the business name of **Geotechnical Services Inc.** by (signature) 

INSTRUCTIONS: Please fill in blanks and circle the correct answers. Send three copies to Kansas Department of Health and Environment, Bureau of Water, 1000 S W Jackson St., Ste. 420, Topeka, Kansas 66612-1367. Telephone: 913-296-5545. Send one to WATER WELL OWNER and retain one for your records.