


1 LOCATION OF WATER WELL: <b>Sedgwick</b> <i>SW</i>	FRACTION <b>NW 1/4 SE 1/4 NW 1/4</b>	Section Number <b>15</b>	Township Number <b>T 29 S</b>	Range Number <b>R 2W E/W</b>
--	---	-----------------------------	----------------------------------	---------------------------------

Distance and direction from nearest town or city street address of well if located within city?

**9042 S. 163rd West Clearwater, Kansas**

2 WATER WELL OWNER: <b>DEVAULT, John</b> RR#, ST. ADDRESS, BOX #: <b>9042 S. 163rd West</b> CITY, STATE, ZIP CODE: <b>Clearwater, Kansas</b>	Board of Agriculture, Division of Water Resource Application Number:
--	---

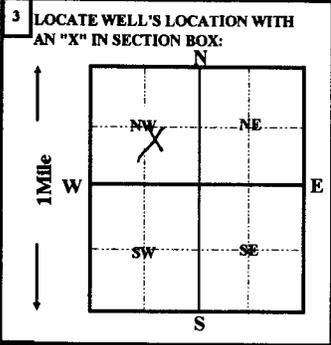

4 DEPTH OF COMPLETED WELL <b>113</b> ft. ELEVATION: Depth(s) groundwater Encountered <b>1</b> ft. <b>2</b> ft. <b>3</b> ft.	WELL'S STATIC WATER LEVEL <b>20</b> FT. BELOW LAND SURFACE MEASURED ON <b>mo/day/yr</b> <b>03/30/1994</b>
Pump test data: Well water was _____ ft. after _____ hours pumping _____ gpm	
Est. Yield _____ gpm: Well water was _____ ft. after _____ hours pumping _____ gpm	
Bore Hole Diameter <b>12</b> in. to <b>113</b> ft. and _____ in. to _____ ft.	
WELL WATER TO BE USED AS: <b>5</b> Public water supply <b>8</b> Air conditioning <b>11</b> Injection well	
<b>1</b> Domestic <b>3</b> Feedlot <b>6</b> Oil field water supply <b>9</b> Dewatering <b>12</b> Other (Specify below)	
<b>2</b> Irrigation <b>4</b> Industrial <b>7</b> Lawn and garden only <b>10</b> Monitoring well	
Was a chemical/bacteriological sample submitted to Department? Yes _____ No <b>X</b> ; If yes, mo/day/yr sample was submitted _____	
Water Well Disinfected? Yes <b>X</b> No _____	

5 TYPE OF CASING USED: 1 Steel <b>3</b> RMP (SR) 2 PVC <b>4</b> ABS	5 Wrought iron 6 Asbestos-Cement 7 Fiberglass	8 Concrete tile 9 Other (Specify below) <b>SDR-26</b>	CASING JOINTS: <b>Glued X Clamped</b> Welded Threaded
Blank casing Diameter <b>5</b> in. to <b>25</b> ft., Dia _____ in. to _____ ft.			
Casing height above land surface <b>12</b> in., weight <b>2.35</b> lbs. / ft. Wall thickness or gauge No. <b>.214</b>			
TYPE OF SCREEN OR PERFORATION MATERIAL: 1 Steel <b>3</b> Stainless Steel <b>5</b> Fiberglass <b>7</b> PVC <b>10</b> Asbestos-cement 2 Brass <b>4</b> Galvanized steel <b>6</b> Concrete tile <b>8</b> RMP (SR) <b>11</b> other (specify) <b>12</b> None used (open hole)			
SCREEN OR PERFORATION OPENING ARE: 1 Continuous slot <b>3</b> Mill slot <b>5</b> Gauzed wrapped <b>8</b> Saw cut <b>11</b> None (open hole) 2 Louvered shutter <b>4</b> Key punched <b>6</b> Wire wrapped <b>9</b> Drilled holes <b>7</b> Torch cut <b>10</b> Other (specify)			
SCREEN-PERFORATION INTERVALS: from <b>25</b> ft. to <b>113</b> ft., From _____ ft. to _____ ft.			
GRAVEL PACK INTERVALS: from <b>24</b> ft. to <b>113</b> ft., From _____ ft. to _____ ft.			

6 GROUT MATERIAL: <b>1</b> Neat cement <b>2</b> Cement grout <b>3</b> Bentonite <b>4</b> Other	Grout Intervals: From <b>4</b> ft. to <b>24</b> ft. From _____ ft. to _____ ft.
What is the nearest source of possible contamination: 1 Septic tank <b>4</b> Lateral lines <b>7</b> Pit privy <b>10</b> Livestock pens <b>14</b> Abandon water well 2 Sewer lines <b>5</b> Cess pool <b>8</b> Sewage lagoon <b>11</b> Fuel storage <b>15</b> Oil well/Gas well 3 Watertight sewer lines <b>6</b> Seepage pit <b>9</b> Feedyard <b>12</b> Fertilizer storage <b>16</b> Other (specify below) <b>13</b> Insecticide storage <b>None Apparent</b>	
Direction from well? _____ How many feet? _____	

FROM	TO	LITHOLOGIC LOG	FROM	TO	PLUGGING INTERVALS
0	3	topsoil			
3	15	clay			<b>SEPTIC SYSTEM NOT INSTALLED AT THIS TIME</b>
15	113	grey shale			

7 CONTRACTOR'S OR LANDOWNER'S CERTIFICATION: This water well was (1) constructed, (2) reconstructed, or (3) plugged under my jurisdiction and was completed on (mo/day/year) <b>03/30/1994</b> and this record is true to the best of my knowledge and belief. Kansas Water Well Contractor's License No. <b>236</b> This Water Well Record was completed on (mo/day/yr) <b>04/08/94</b> Under the business name of <b>Harp Well &amp; Pump Service, Inc.</b> by (signature)	<i>Jane Frederick</i>
---	-----------------------