


1 LOCATION OF WATER WELL: County: Sedgewick Fraction: NW 1/4 NW 1/4 NW 1/4 Section Number: 27 Township Number: T 29 S Range Number: R 2 E (W)

Distance and direction from nearest town or city street address of well if located within city?

2 West Clearwater, KS

2 WATER WELL OWNER: Bob Williams
RR#, St. Address, Box #: P.O. Box 37
City, State, ZIP Code: Clearwater, KS 67026
Board of Agriculture, Division of Water Resources
Application Number:

3 LOCATE WELL'S LOCATION WITH AN "X" IN SECTION BOX:

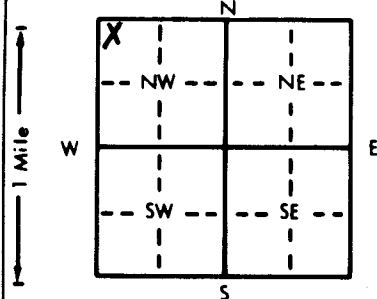

4 DEPTH OF COMPLETED WELL: 40 ft. ELEVATION:

Depth(s) Groundwater Encountered 1. 20 ft. 2. 20 ft. 3. 20 ft.

WELL'S STATIC WATER LEVEL 20 ft. below land surface measured on mo/day/yr 7-7-86

Pump test data: Well water was 20 ft. after 12 hours pumping 20 gpm

Est. Yield 35 gpm: Well water was 20 ft. after 12 hours pumping 20 gpm

Bore Hole Diameter 11 in. to 40 ft. and 40 in. to 40 ft.

WELL WATER TO BE USED AS: 5 Public water supply 8 Air conditioning 11 Injection well

1 Domestic 3 Feedlot 6 Oil field water supply 9 Dewatering 12 Other (Specify below)

2 Irrigation 4 Industrial 7 Lawn and garden only 10 Observation well

Was a chemical/bacteriological sample submitted to Department? Yes X No X; If yes, mo/day/yr sample was submitted

Water Well Disinfected? Yes X No

5 TYPE OF BLANK CASING USED: 1 Steel 2 PVC 3 RMP (SR) 4 ABS 5 Wrought iron 6 Asbestos-Cement 7 Fiberglass 8 Concrete tile 9 Other (specify below) CASING JOINTS: Glued X Clamped Welded Threaded

Blank casing diameter 5 in. to 20 ft. Dia. 5 in. to 20 ft. Dia. 5 in. to 20 ft.

Casing height above land surface 12 in., weight 1.59 lbs./ft. Wall thickness or gauge No. 50R-26

TYPE OF SCREEN OR PERFORATION MATERIAL: 1 Steel 2 Brass 3 Stainless steel 4 Galvanized steel 5 Fiberglass 6 Concrete tile 7 PVC 8 RMP (SR) 9 ABS 10 Asbestos-cement 11 Other (specify) 12 None used (open hole)

SCREEN OR PERFORATION OPENINGS ARE: 1 Continuous slot 2 Louvered shutter 3 Mill slot 4 Key punched 5 Gauzed wrapped 6 Wire wrapped 7 Torch cut 8 Saw cut 9 Drilled holes 10 Other (specify) 11 None (open hole)

SCREEN-PERFORATED INTERVALS: From 20 ft. to 40 ft. From 20 ft. to 40 ft. From 20 ft. to 40 ft.

GRAVEL PACK INTERVALS: From 15 ft. to 40 ft. From 15 ft. to 40 ft. From 15 ft. to 40 ft.

6 GROUT MATERIAL: 1 Neat cement 2 Cement grout 3 Bentonite 4 Other

Grout Intervals: From 5 ft. to 15 ft. From 5 ft. to 15 ft. From 5 ft. to 15 ft.

What is the nearest source of possible contamination: 1 Septic tank 2 Sewer lines 3 Watertight sewer lines 4 Lateral lines 5 Cess pool 6 Seepage pit 7 Pit privy 8 Sewage lagoon 9 Feedyard 10 Livestock pens 11 Fuel storage 12 Fertilizer storage 13 Insecticide storage 14 Abandoned water well 15 Oil well/Gas well 16 Other (specify below)

Direction from well? South How many feet? 100

FROM TO LITHOLOGIC LOG FROM TO LITHOLOGIC LOG

0 2 top so. l

2 20 clay.

20 26 sand.

26 40 gray shale

7 CONTRACTOR'S OR LANDOWNER'S CERTIFICATION: This water well was (1) constructed, (2) reconstructed, or (3) plugged under my jurisdiction and was completed on (mo/day/year) 7-7-86 and this record is true to the best of my knowledge and belief. Kansas

Water Well Contractor's License No. 318 This Water Well Record was completed on (mo/day/yr) 7-11-86

under the business name of Weninger Drilling by (signature) Weninger

INSTRUCTIONS: Use typewriter or ball point pen. PLEASE PRESS FIRMLY and PRINT clearly. Please fill in blanks, underline or circle the correct answers. Send top three copies to Kansas

Department of Health and Environment, Office of Oil Field and Environmental Geology, Regulation and Permitting Section, Topeka, Kansas 66620-7500, Telephone: 913-862-9360. Send one

to WATER WELL OWNER and retain one for your records.