USE TYPEWRITER OR BALL POINT PEN-PRESS FIRMLY, PRINT CLEARLY.

WATER WELL RECORD
KSA 82a-1201-1215

Kansas Department of Health and Environment-Division of Environment
(Water well Contractors)
Topeka, Kansas 66620

1. Location of well: County: Kiowa | Fraction: Center 1/4 NW 1/4 SW | Section number: 15 | Township number: T 29 S | Range number: R 20 W E/W

2. Distance and direction from nearest town or city: 1 Mile north of Mills - 1/2 South East side

Street address of well location if in city:

3. Owner of well: Clay Drilling Co.
R.R. or street: 434 Pi Jacket
City, state, zip code: Wichita Kansas 67202

4. Locate with "X" in section below:

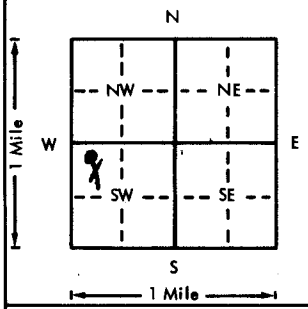

Sketch map:

6. Bore hole dia. 8 in. Completion date 6-24-76
Well depth 150 ft.

7. __ Cable tool X Rotary __ Driven __ Dug
__ Hollow rod __ Jetted __ Bored __ Reverse rotary

8. Use: __ Domestic __ Public supply __ Industry
__ Irrigation __ Air conditioning __ Stock
__ Lawn X Oil field water __ Other

9. Casing: Material PVC Height: Above or ~~below~~
Threaded __ Welded X Surface 12 in.
RMP __ PVC X Weight 2.023 lbs./ft.
Dia. 4 in. to 150 ft. depth Wall Thickness: inches or
Dia. __ in. to __ ft. depth gage No. Schedule 40

10. Screen: Manufacturer's name Mills Wallwater
Type Slot Dia. 4"
Slot/gauze 16 Length 20 ft
Set between 130 ft. and 150 ft.
__ ft. and __ ft.
Gravel pack? X Size range of material 1/8 - 1/4

11. Static water level: 118 ft. below land surface Date 6-24-76 mo./day/yr.

12. Pumping level below land surfaces: 128 ft. after 1 hrs. pumping 40 g.p.m.
__ ft. after __ hrs. pumping __ g.p.m.
Estimated maximum yield 150 g.p.m.

13. Water sample submitted: mo./day/yr.
__ Yes X No Date

14. Well head completion:
__ Pitless adapter X Inches above grade

15. Well grouted? X
With: __ Neat cement X Bentonite __ Concrete
Depth: From 0 ft. to 50 ft.

16. Nearest source of possible contamination:
ft. __ Direction __ Type

Well disinfected upon completion? __ Yes __ No

17. Pump: X Not installed
Manufacturer's name
Model number HP Volts
Length of drop pipe ft. capacity g.p.m.
Type:
__ Submersible __ Turbine
__ Jet __ Reciprocating
__ Centrifugal __ Other

5. Type and color of material

	From	To
Clay + Fine Sand	0	80
Clay	80	118
~~Shale~~	118	150
Gravel		

(Use o second sheet if needed)

18. Elevation:

Topography:
__ Hill
X Slope
__ Upland
__ Valley

19. Remarks:

20. Water well contractor's certification:
This well was drilled under my jurisdiction and this report is true to the best of my knowledge and belief.
Business name Mills Wallwater License No. 142
Address Yoder Kansas
Signed Authorized representative Date 6-30-76

29 T 20 R W 15 Sec C NW SW 1/4 1/4 1/4

Forward the white, blue and pink copies to the Department of Health and Environment

Form WWC-5

M1-1023