


1 LOCATION OF WATER WELL: Fraction Section Number Township Number Range Number  
 County: Kiowa C 1/4 SW 1/4 NE 1/4 17 T 29 S R 20 EW

Distance and direction from nearest town or city street address of well if located within city?  
4 south 2 3/4 west of Mullinville

2 WATER WELL OWNER: V. Miller Wheatstate Drilling  
 RR#, St. Address, Box #: Cimarron, Ks. Box 947 Board of Agriculture, Division of Water Resources  
 City, State, ZIP Code: Pratt, Ks. 67124 Application Number: T84-42

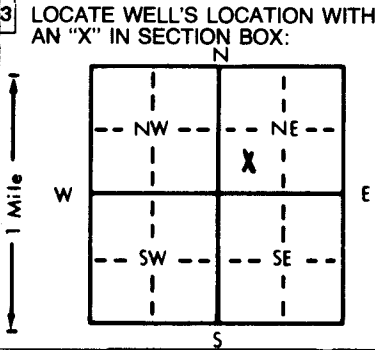

4 DEPTH OF COMPLETED WELL... 200 ft. ELEVATION: .....

Depth(s) Groundwater Encountered 1. 4.6 ft. 2. .... ft. 3. .... ft.

WELL'S STATIC WATER LEVEL ... 14.2 ft. below land surface measured on mo/day/yr ... 1-25-84 .....

Pump test data: Well water was ..... ft. after ..... hours pumping ..... gpm

Est. Yield NA gpm: Well water was ..... ft. after ..... hours pumping ..... gpm

Bore Hole Diameter... 1.0 in. to 2.00 in. to ..... in. to ..... in.

WELL WATER TO BE USED AS: 5 Public water supply 8 Air conditioning 11 Injection well  
 1 Domestic 3 Feedlot 6 Oil field water supply 9 Dewatering 12 Other (Specify below)  
 2 Irrigation 4 Industrial 7 Lawn and garden only 10 Observation well

Was a chemical/bacteriological sample submitted to Department? Yes.....No. x.....; If yes, mo/day/yr sample was submitted

Water Well Disinfected? Yes HTH No

5 TYPE OF BLANK CASING USED: 5 Wrought iron 8 Concrete tile CASING JOINTS: Glued x Clamped .....

1 Steel 3 RMP (SR) 6 Asbestos-Cement 9 Other (specify below) Welded .....

2 PVC 4 ABS 7 Fiberglass Threaded .....

Blank casing diameter ... 5 in. to 18.0 in. Dia. .... in. to ..... in. Dia. .... in. to ..... in.

Casing height above land surface ... 18 in., weight ..... lbs./ft. Wall thickness or gauge No. 2.58

TYPE OF SCREEN OR PERFORATION MATERIAL: 7 PVC 10 Asbestos-cement

1 Steel 3 Stainless steel 5 Fiberglass 8 RMP (SR) 11 Other (specify) .....

2 Brass 4 Galvanized steel 6 Concrete tile 9 ABS 12 None used (open hole)

SCREEN OR PERFORATION OPENINGS ARE: 5 Gauzed wrapped 8 Saw cut 11 None (open hole)

1 Continuous slot 3 Mill slot 6 Wire wrapped 9 Drilled holes

2 Louvered shutter 4 Key punched 7 Torch cut 10 Other (specify) .....

SCREEN-PERFORATED INTERVALS: From ... 18.0 ft. to 200 ft., From ..... ft. to ..... ft.

GRAVEL PACK INTERVALS: From ... 1.0 ft. to 200 ft., From ..... ft. to ..... ft.

6 GROUT MATERIAL: 1 Neat cement 2 Cement grout 3 Bentonite 4 Other .....

Grout Intervals: From ..... 0 ft. to 1.0 ft., From ..... ft. to ..... ft., From ..... ft. to ..... ft.

What is the nearest source of possible contamination:

1 Septic tank 4 Lateral lines 7 Pit privy 10 Livestock pens 14 Abandoned water well

2 Sewer lines 5 Cess pool 8 Sewage lagoon 11 Fuel storage 15 Oil well/Gas well

3 Watertight sewer lines 6 Seepage pit 9 Feedyard 12 Fertilizer storage 16 Other (specify below)

13 Insecticide storage

Direction from well? west How many feet? 80

FROM	TO	LITHOLOGIC LOG	FROM	TO	LITHOLOGIC LOG
0	2	Top soil			
2	460	Brown clay			
46	51	Sand			
51	97	Clay			
97	111	Sand w/strips of clay			
111	197	Sand and gravel			
197	200	Shale			

7 CONTRACTOR'S OR LANDOWNER'S CERTIFICATION: This water well was (1) constructed, (2) reconstructed, or (3) plugged under my jurisdiction and was completed on (mo/day/year) ... 1-25-84 ... and this record is true to the best of my knowledge and belief. Kansas Water Well Contractor's License No. ... 134 ... This Water Well Record was completed on (mo/day/yr) ... 2-1-84 ... under the business name of Rosencrantz=Bemis Ent. by (signature) Donna Dodson

INSTRUCTIONS: Use typewriter or ball point pen, PLEASE PRESS FIRMLY and PRINT clearly. Please fill in blanks, underline or circle the correct answers. Send top three copies to Kansas Department of Health and Environment, Division of Environment, Environmental Geology Section, Topeka, KS 66620. Send one to WATER WELL OWNER and retain one for your records.

OFFICE USE ONLY T 29 R 20 EW SEC 17 C 1/4 SW 1/4 NE 1/4

D