

344


WATER WELL RECORD Form WWC-5 KSA 82a-1212

1 LOCATION OF WATER WELL: Fraction SE 1/4 SE 1/4 SW 1/4 Section Number 22 Township Number T 29 S Range Number R 20 W  
 COUNTY: KIOWA

Distance and direction from nearest town or city street address of well if located within city?  
 6 MILES SOUTH, 1 MILE WEST OF MULLINVILLE

2 WATER WELL OWNER: MCDONALD, VERLIN D. Board of Agriculture, Division of Water Resources  
 RR#, St. Address, Box # : City, State, ZIP code : MULLINVILLE, KS 67109- Application Number: |

3 LOCATE WELL'S LOCATION WITH AN "X" IN SECTION BOX:

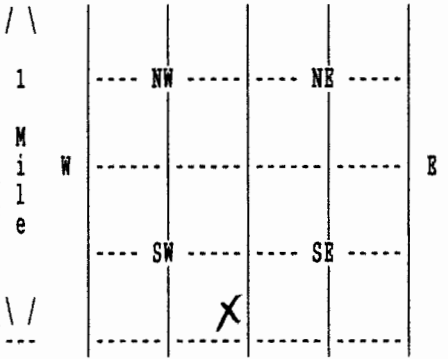

4 DEPTH OF COMPLETED WELL 250 ELEVATION: 0  
 Depth(s) Groundwater Encountered 1. 0 ft. 2. 0 ft. 3. 0 ft.  
 WELL'S STATIC WATER LEVEL 190 ft. below land surface measured on mo/day/yr 09/29/09  
 Pump test data: Well water was 0 ft. after 0 hours pumping 0 gpm  
 Estimated Yield 0 gpm: Well water was 0 ft. after 0 hours pumping 0 gpm  
 Bore Hole Diameter 8.75 in. to 250 ft., and in. to 0 ft.  
 WELL WATER TO BE USED AS: LIVESTOCK  
 Was a chemical/bacteriological sample submitted to department? No ;  
 If yes, mo/day/yr sample was submitted Water well disinfected? Yes

5 TYPE OF BLANK CASING USED: PVC CASING JOINTS: GLUED  
 Blank casing diameter 5 in. to 230 ft., Dia in. to 0 ft., Dia in. to 0 ft.  
 Casing height above land surface 12 in., weight 0 lbs/ft. Wall thickness or gauge No. 21  
 TYPE OF SCREEN OR PERFORATION MATERIAL: PVC  
 SCREEN OR PERFORATION OPENINGS ARE: SAW CUT

SCREEN PERFORATED INTERVALS: From 230 ft. to 250 ft., From 0 ft. to 0 ft.  
 From 0 ft. to 0 ft., From 0 ft. to 0 ft.  
 GRAVEL PACK INTERVALS: From 23 ft. to 250 ft., From 0 ft. to 0 ft.  
 From 0 ft. to 0 ft., From 0 ft. to 0 ft.

6 GROUT MATERIAL BENTONITE  
 Grout Intervals: From 0 ft. to 23 ft., From 0 ft. to 0 ft., From 0 ft. to 0 ft.  
 What is the nearest source of possible contamination: SEPTIC TANK  
 Direction from well? NORTH How many feet? 8000

| FROM | TO  | LITHOLOGIC LOG  | FROM | TO | PLUGGING INTERVALS |
|------|-----|-----------------|------|----|--------------------|
| 0    | 178 | TAN CLAY        |      |    |                    |
| 178  | 245 | SAND AND GRAVEL |      |    |                    |
| 245  | 250 | GRAY SHALE      |      |    |                    |

7 CONTRACTOR'S OR LANDOWNER'S CERTIFICATION: This water well was Constructed under my jurisdiction and was completed on (mo/day/year) 09/29/09 and this record is true to the best of my knowledge and belief. Kansas Water Well Contractor's License No. 653 This Water Well Record was completed on (mo/day/yr) 12/29/09 under the business name of DAN HAYSE WATER WELL SERV by (signature) Dan Hayse

White