


WATER WELL RECORD Form WWC-5 KSA 82a-1212

1 LOCATION OF WATER WELL: Fraction Section Number Township Number Range Number
 COUNTY: 049 KIOWA SW 1/4 SW 1/4 SW 1/4 6 T 29 S R 20 W

Distance and direction from nearest town or city street address of well if located within city?
 3 W. 1 1/2 S. OF MULLINVILLE, KS

2 WATER WELL OWNER: GENE RUDD PAMAR INC 311 Board of Agriculture, Division of Water Resources
 RR#, St. Address, Box #: 614 MAGNOLIA
 City, State, ZIP code: GARDEN CITY, KS 67846- Application Number:

3 LOCATE WELL'S LOCATION WITH AN "X" IN SECTION BOX:

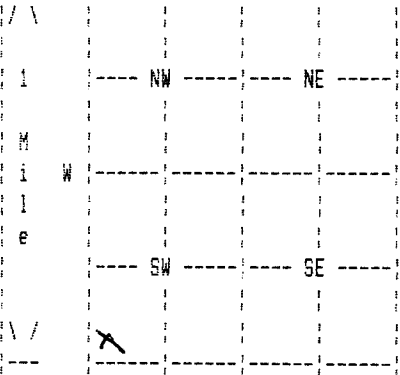

4 DEPTH OF COMPLETED WELL 160 ELEVATION: 0
 Depth(s) Groundwater Encountered 1. 107 ft. 2. 0 ft. 3. 0 ft.
 WELL'S STATIC WATER LEVEL 107 ft. below land surface measured on mo/day/yr
 Pump test data: Well water was 0 ft. after 0 hours pumping 0 gpm
 Estimated Yield 0 gpm: Well water was 0 ft. after 0 hours pumping 0 gpm
 Bore Hole Diameter 8.75 in. to 160 ft., and in. to 0 ft.
 WELL WATER TO BE USED AS: 01 DOMESTIC
 Was a chemical/bacteriological sample submitted to department? No ;
 If yes, mo/day/yr sample was submitted Water well disinfected? Yes

5 TYPE OF BLANK CASING USED: 02 PVC CASING JOINTS: BLUED
 Blank casing diameter 5 in. to 140 ft., Dia in. to 0 ft., Dia in. to 0 ft.
 Casing height above land surface 12 in., weight 0 lbs/ft. Wall thickness or gauge No. 26-21
 TYPE OF SCREEN OR PERFORATION MATERIAL: 07 PVC
 SCREEN OR PERFORATION OPENINGS ARE: 08 SAW CUT

SCREEN PERFORATED INTERVALS: From 140 ft. to 160 ft., From 0 ft. to 0 ft.
 From 0 ft. to 0 ft., From 0 ft. to 0 ft.
 GRAVEL PACK INTERVALS: From 25 ft. to 160 ft., From 0 ft. to 0 ft.
 From 0 ft. to 0 ft., From 0 ft. to 0 ft.

6 GROUT MATERIAL 03 BENTONITE
 Grout Intervals: From 1 ft. to 25 ft., From 0 ft. to 0 ft., From 0 ft. to 0 ft.
 What is the nearest source of possible contamination: CATTLE PASTURE
 Direction from well? ALL How many feet? 5

FROM	TO	LITHOLOGIC LOG	FROM	TO	PLUGGING INTERVALS
0	93	TAN CLAY			
93	121	05 SAND AND 17 GRAVEL			
121	138	TAN CLAY			
138	143	05 SAND AND 17 GRAVEL			
143	156	TAN CLAY			
156	159	05 SAND AND 17 GRAVEL			
159	160	GREY CLAY			

7 CONTRACTOR'S OR LANDOWNER'S CERTIFICATION: This water well was Constructed under my jurisdiction and was completed on (mo/day/year) 4 /6 /95 and this record is true to the best of my knowledge and belief. Kansas Water Well Contractor's License No. 224 This Water Well Record was completed on (mo/day/yr) 04/16/95 under the business name of CARL HAYSE WATER WELL SVC by (signature) Carl Hayse