USE TYPEWRITER OR BALL POINT PEN-PRESS FIRMLY, PRINT CLEARLY.

T R EW sec 1/4 1/4 1/4 No.

WATER WELL RECORD
KSA 82a-1201-1215

Kansas State Dept. Of Health
(Water Well Contractors)
Forbes-Bldg. 740
Topeka, Kansas 66620

1 Location of well:	County	Township name	Fraction	Section number	Town number	Range number
	Ford	Bucklin	SW 1/4 SW 1/4	4	T-29-S	R-21-W

Distance and direction from nearest town or city: 1/4 M. East Bucklin
Street address of well location if in city:

3 Owner of well: Gordon Barnhart
Address: Bucklin Kansas

Locate with "X" in section below:

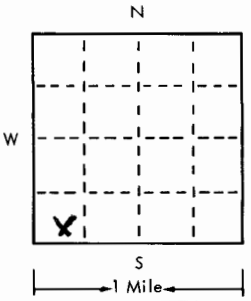

Sketch map:

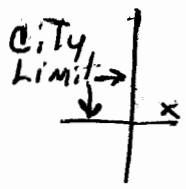

4 Well depth: 114 ft. Date of completion 2-7-75
Well diameter 8 5/8 in.

5 ☐ Cable tool ☒ Rotary ☐ Driven ☐ Dug ☐ Hollow rod ☐ Jetted ☐ Bored ☐ Reverse rotary

6 Use: ☒ Domestic ☐ Public supply ☐ Industry ☐ Irrigation ☐ Air conditioning ☐ Commercial ☐ Test well ☐ _____

7 Casing: Material RMP Height: (Above)/below
Threaded ☐ Welded ☐ Surface 12 in.
Diam. 5 in. to 114 ft. depth Weight 20# lbs./ft.
___ in. to ___ ft. depth Drive shoe? ☐ Yes ☒ No

2 Type and color of material	From	To
Top Soil	0	3
Tan Clay	3	10
LT. Brown Clay	10	76
Gravel	76	98
Clay - White	98	100
Gravel	100	110
Clay - White	110	114

(use a second sheet if needed)

8 Screen:
Manufacturer Jessy Lowell
Type RMP Dia. 5"
Slot/gauze 1/8 Length 30'
Set between 84 ft. and 114 ft.
Fittings:
Gravel pack ☒ Yes ☐ No Size range of material 1/4

9 Static water level:
89 ft. below land surface Date 2-7-75

10 Pumping level below land surfaces:
100 ft. after 2 hrs. pumping 12 g.p.m.
___ ft. after ___ hrs. pumping ___ g.p.m.
Estimated maximum yield 15 g.p.m.

11 Water sample submitted:
☐ Yes ☒ No Date _____

12 Well head completion:
☒ Pitless adapter 12 inches above grade

13 Well grouted? ☒ Yes ☐ No
☒ Neat cement ☐ Bentonite ☐ _____
Depth: From 4 ft. to 14 ft.

14 Nearest source of possible contamination: Septic Field
ft. 15 Direction East Type Installed
Well disinfected upon completion? ☒ Yes ☐ No

15 Pump: ☐ Not installed
Manufacturer's name F & W
Model number 10BA 12 HP 1 Volts 220
Length of drop pipe 104 ft. capacity 12 g.p.m.
Type:
☒ Submersible ☐ Turbine
☐ Jet ☐ Reciprocating
☐ Certrifugal ☐ Other

16 Remarks: ~~elevation~~ This is For a new house AND At the Time of Drilling The Foundation Was Not Completed.

Topography:
☐ Hill
☒ Slope
☐ Upland
☐ Valley

17 Water well contractor's certification:
This well was drilled under my jurisdiction and this report is true to the best of my knowledge and belief.
Carl Hayse Well Service
Business name License No. 224
Address 603 So. Main
Signed Carl Hayse Date 2-11-75
Authorized representative

Forward the white, blue and pink copies to the Kansas State Dept. Of Health.

Form WWC-5

Revised As ordered

677-H