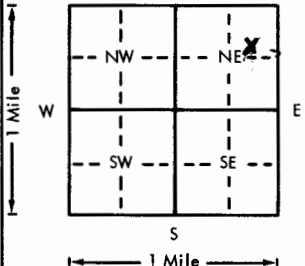


USE TYPEWRITER OR BALL
POINT PEN-PRESS FIRMLY,
PRINT CLEARLY.

WATER WELL RECORD
KSA 82a-1201-1215

Kansas Department of Health and
Environment-Division of Environment
(Water well Contractors)
Topeka, Kansas 66620

1. Location of well:		County FORD	Fraction NE 1/4 NE 1/4 SW 1/4	Section number 8	Township number T 29 S	Range number R 21 E
2. Distance and direction from nearest town or city: 1/2 SOUTH BUCKIN			3. Owner of well: JOHN F. SWAYZE			
Street address of well location if in city:			R.R. or street: BUCKLIN, KANS.			
4. Locate with "X" in section below:			City, state, zip code:			
<div>Sketch map: </div>						
5. Type and color of material			From	To	6. Bore hole dia. 6 1/2" in. Completion date 10-18-76	
Top soil			0	10'	Well depth 100 ft.	
Clay			10'	75'	7. Cable tool <input checked="" type="checkbox"/> Rotary <input type="checkbox"/> Driven <input type="checkbox"/> Dug	
Sand + GRAVEL			75'	100'	<input type="checkbox"/> Hollow rod <input type="checkbox"/> Jetted <input type="checkbox"/> Bored <input type="checkbox"/> Reverse rotary	
					8. Use: <input checked="" type="checkbox"/> Domestic <input type="checkbox"/> Public supply <input type="checkbox"/> Industry	
					<input type="checkbox"/> Irrigation <input type="checkbox"/> Air conditioning <input type="checkbox"/> Stock	
					<input checked="" type="checkbox"/> Lawn <input type="checkbox"/> Oil field water <input type="checkbox"/> Other	
					9. Casing: Material PVC Height Above or below	
					Threaded <input type="checkbox"/> Welded <input type="checkbox"/> Surface 12 in.	
					RMP <input type="checkbox"/> PVC <input checked="" type="checkbox"/> Weight 12 lbs./ft.	
					Dia. 5 in. to 10 ft. depth Wall Thickness: inches or	
					Dia. 4 in. to 100 ft. depth gage No. 100	
					10. Screen: Manufacturer's name BRAN SAVER	
					Type PVC Dia. 4 1/2"	
					Slot/gauze 1/16" Length 20'	
					Set between 80 ft. and 100 ft.	
					Gravel pack? Yes Size range of material 1/4"	
					11. Static water level: 80 ft. below land surface Date Oct 20, 76	
					12. Pumping level below land surfaces: NOT PUMPED	
					Estimated maximum yield 5-10 g.p.m.	
					13. Water sample submitted: Yes <input checked="" type="checkbox"/> No <input type="checkbox"/> Date 10-28-76	
					14. Well head completion: X Pitless adapter 12" 12" inches above grade	
					15. Well grouted? Yes	
					With: <input type="checkbox"/> Neat cement <input type="checkbox"/> Bentonite <input checked="" type="checkbox"/> Concrete	
					Depth: From 0 ft. to 10 ft.	
					16. Nearest source of possible contamination: None	
					ft. At present - No	
					Well disinfected upon completion NO SEPTIC TANK	
					17. Pump: Goulds Not installed	
					Manufacturer's name Steel	
					Model number 1 1/2 HP 1 1/2 Volts 220	
					Length of drop pipe 100 ft. capacity 7 g.p.m.	
					Type: <input checked="" type="checkbox"/> Submersible <input type="checkbox"/> Turbine	
					<input type="checkbox"/> Jet <input type="checkbox"/> Reciprocating	
					<input type="checkbox"/> Centrifugal <input type="checkbox"/> Other	
18. Elevation:			19. Remarks:			
Topography: <input type="checkbox"/> Hill <input type="checkbox"/> Slope <input type="checkbox"/> Upland <input type="checkbox"/> Valley			NEW HOUSE IS BEING BUILT			
			WELL Drilled before much construction			
			was done - NO SEPTIC TANK INSTALLED			
			Yet.			
			20. Water well contractor's certification:			
			This well was drilled under my jurisdiction and this report is true to the best of my knowledge and belief.			
			Business name Adair & Brandt License No. 217			
			Address Bucklin, KS			
			Signed [Signature] Date 10-28-76			