WATER WELL RECORD Form WWC-5 KSA 82a-1212

1 LOCATION OF WATER WELL: County: FORD | Fraction: NE ¼ SW ¼ SW ¼ | Section Number: 28 | Township Number: T 29 S | Range Number: R 21 E(W)

Distance and direction from nearest town or city street address of well if located within city? 3 3/4 South - 1/4 East of Bucklin, KS.

2 WATER WELL OWNER: MRS. FRED FLETCHER

RR#, St. Address, Box # : Bucklin KS 67834

City, State, ZIP Code :

Board of Agriculture, Division of Water Resources Application Number:

3 LOCATE WELL'S LOCATION WITH AN "X" IN SECTION BOX:

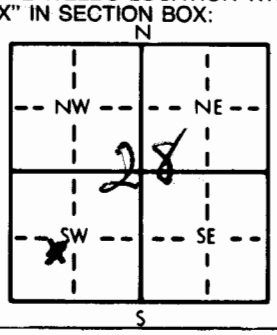

4 DEPTH OF COMPLETED WELL 280 ft. ELEVATION:

Depth(s) Groundwater Encountered 1. 195 ft. 2. ft. 3. ft.

WELL'S STATIC WATER LEVEL 190 ft. below land surface measured on mo/day/yr 5-8-89

Pump test data: Well water was not pumped ft. after hours pumping gpm

Est. Yield 10 gpm: Well water was ft. after hours pumping gpm

Bore Hole Diameter 8 in. to 280 ft., and in. to ft.

WELL WATER TO BE USED AS: 1 Domestic 2 Irrigation 3 Feedlot 4 Industrial 5 Public water supply 6 Oil field water supply 7 Lawn and garden only 8 Air conditioning 9 Dewatering 10 Monitoring well 11 Injection well 12 Other (Specify below) Livestock

Was a chemical/bacteriological sample submitted to Department? Yes No X; If yes, mo/day/yr sample was submitted

Water Well Disinfected? Yes X No

5 TYPE OF BLANK CASING USED: 1 Steel 2 PVC 3 RMP (SR) 4 ABS 5 Wrought iron 6 Asbestos-Cement 7 Fiberglass 8 Concrete tile 9 Other (specify below)

CASING JOINTS: Glued X Clamped Welded Threaded

Blank casing diameter 4 in. to 260 ft., Dia in. to ft., Dia in. to ft.

Casing height above land surface 12 in., weight 1.895 lbs./ft. Wall thickness or gauge No. SDR 21

TYPE OF SCREEN OR PERFORATION MATERIAL: 1 Steel 2 Brass 3 Stainless steel 4 Galvanized steel 5 Fiberglass 6 Concrete tile 7 PVC 8 RMP (SR) 9 ABS 10 Asbestos-cement 11 Other (specify) 12 None used (open hole)

SCREEN OR PERFORATION OPENINGS ARE: 1 Continuous slot 2 Louvered shutter 3 Mill slot 4 Key punched 5 Gauzed wrapped 6 Wire wrapped 7 Torch cut 8 Saw cut 9 Drilled holes 10 Other (specify) 11 None (open hole)

SCREEN-PERFORATED INTERVALS: From [redacted] ft. to ft., From ft. to ft.

From 260 ft. to 280 ft., From ft. to ft.

GRAVEL PACK INTERVALS: From 20 ft. to 280 ft., From ft. to ft.

From ft. to ft., From ft. to ft.

6 GROUT MATERIAL: 1 Neat cement 2 Cement grout 3 Bentonite 4 Other

Grout Intervals: From 0 ft. to 20 ft., From ft. to ft., From ft. to ft.

What is the nearest source of possible contamination: none within sight

1 Septic tank 2 Sewer lines 3 Watertight sewer lines 4 Lateral lines 5 Cess pool 6 Seepage pit 7 Pit privy 8 Sewage lagoon 9 Feedyard 10 Livestock pens 11 Fuel storage 12 Fertilizer storage 13 Insecticide storage 14 Abandoned water well 15 Oil well/Gas well 16 Other (specify below)

Direction from well? How many feet?

FROM	TO	LITHOLOGIC LOG	FROM	TO	PLUGGING INTERVALS
0	10	topsoil & clay			
10	120	Clay			
120	145	Sandy clay			
145	180	Clay			
180	195	Fine sand			
195	280	Sand + Gravel			
280		Shale			

7 CONTRACTOR'S OR LANDOWNER'S CERTIFICATION: This water well was (1) constructed, (2) reconstructed, or (3) plugged under my jurisdiction and was completed on (mo/day/year) 5-25-89 and this record is true to the best of my knowledge and belief. Kansas Water Well Contractor's License No. 217 This Water Well Record was completed on (mo/day/yr) 6-7-89 under the business name of Brau Drilling Co. by (signature)

INSTRUCTIONS: Use typewriter or ball point pen. *PLEASE PRESS FIRMLY* and *PRINT* clearly. Please fill in blanks, underline or circle the correct answers. Send top three copies to Kansas Department of Health and Environment, Bureau of Water Protection, Topeka, Kansas 66620-7320. Telephone: 913-296-5514. Send one to WATER WELL OWNER and retain one for your records.

OFFICE USE ONLY T R E/W SEC. ¼ ¼ ¼