396 9407 WATER WELL PLUGGING RECORD Form WWC-5P KSA82a-1212 ID NO. Well #9

1 LOCATION OF WATER WELL:	Fraction	Section Number	Township Number	Range Number
County: Ford	SE 1/4 NE 1/4 SW 1/4	5	T 29 S	R 21 E (W)

Distance and direction from nearest town or city street address of well if located within city?

Approximately 60' west of the intersection of W. Cedar St. and Washington St. in Bucklin

2 WATER WELL OWNER: City of Bucklin
117 W. Oak
RR#, St. Address, Box # P.O. Box 458
City, State, ZIP Code Bucklin, KS 67834

Board of Agriculture, Division of Water Resources
Application Number: FO 4, 3690, and 34,598

3 MARK WELL'S LOCATION WITH AN "X" IN SECTION BOX:

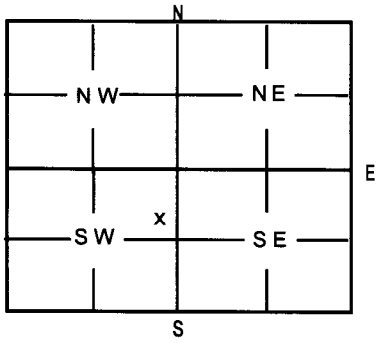

4 DEPTH OF WELL 142 ft

WELL'S STATIC WATER LEVEL 107 ft.

WELL WAS USED AS:

1 Domestic (5) Public Water Supply 9 Dewatering
2 Irrigation 6 Oil Field Water Supply 10 Monitoring Well
3 Feedlot 7 Domestic (Lawn & Garden) 11 Injection Well
4 Industrial 8 Air Conditioning 12 Other

Was a chemical / bacteriological sample submitted to Department? Yes ___ No ✓

If yes, mo/day/yr sample was submitted ___

Water Well Disinfected: Yes ✓ No ___

5 TYPE OF BLANK CASING USED:

(1) Steel 3 RMP (SR) 5 Wrought 7 Fiberglass 9 Other (Specify below)
2 PVC 4 ABS 6 Asbestos-Cement 8 Concrete Tile

Blank casing diameter 12 in. Was casing pulled? Yes ___ No ✓ If yes, how much ___

Casing height above or (below) land surface 60 in.

6 GROUT PLUG MATERIAL: 1 Neat Cement (2) Cement grout (3) Bentonite 4 Other ___

Grout Plug Intervals: From 7 ft. to 4 ft., From 107 ft. to 7 ft. From ___ ft. to ___ ft.

What is the nearest source of possible contamination:

1 Septic tank 6 Seepage pit 11 Fuel storage (16) Other (specify below)
2 Sewer lines 7 Pit privy 12 Fertilizer storage
3 Watertight sewer lines 8 Sewage lagoon 13 Insecticide storage None known
4 Lateral lines 9 Feedyard 14 Abandoned water well
5 Cess Pool 10 Livestock pens 15 Oil well/Gas well

Direction from well? ___ How many feet? ___

FROM	TO	PLUGGING MATERIALS
142	107	Chlorinated Sand
107	7	Bentonite Holeplug
7	4	Concrete Grout
4	0.5	Fill Sand Under Pumphouse Floor
0.5	0	Pumphouse Floor

7 CONTRACTOR'S OR LANDOWNER'S CERTIFICATION: This water well was plugged under my jurisdiction and was completed on (mo/day/year) 04-29-09 and this record is true to the best of my knowledge and belief. Kansas Water Well Contractor's License No. 185 This Water Well Record was completed on (mo/day/year) 05-01-09 under the business name of Clarke Well & Equipment, Inc.

by (signature) [signature]

INSTRUCTIONS: Use typewriter or ball point pen. Please press firmly and print clearly. Please fill in blanks, underline or circle the correct answers. Send top three copies to Kansas Department of Health & Environment, Bureau of Water, Topeka, Kansas 66620-0001. Telephone: 785/296-3565. Send one to Water Well Owner and retain one for your records.