WATER WELL RECORD Form WWC-5 KSA 82a-1212

1 LOCATION OF WATER WELL: County: Ford | Fraction: SW ¼ SW ¼ SW ¼ | Section Number: 3 | Township Number: T 29 S | Range Number: R 22 E(W)

Distance and direction from nearest town or city street address of well if located within city? 2 miles East of ~~Bunkiday~~ Kingsdown, Kansas and ½ mile North

2 WATER WELL OWNER: Silverado Drilling Co. (Fred Rice #3-13) Rig #8

RR#, St. Address, Box # : 220 W. Douglas

City, State, ZIP Code : Wichita, Kansas 67202

Board of Agriculture, Division of Water Resources Application Number:

3 LOCATE WELL'S LOCATION WITH AN "X" IN SECTION BOX:

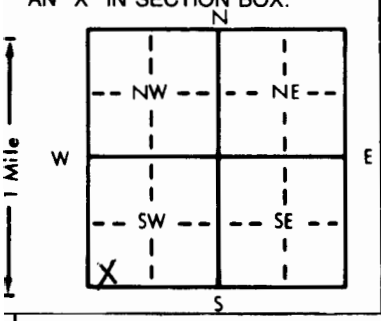

4 DEPTH OF COMPLETED WELL 180 ft. ELEVATION:

Depth(s) Groundwater Encountered 1. ft. 2. ft. 3. ft.

WELL'S STATIC WATER LEVEL 130 ft. below land surface measured on mo/day/yr 8-28-81

Pump test data: Well water was ft. after hours pumping gpm

Est. Yield 70 gpm: Well water was ft. after hours pumping gpm

Bore Hole Diameter 8 in. to 180 ft., and in. to ft.

WELL WATER TO BE USED AS: 1 Domestic 2 Irrigation 3 Feedlot 4 Industrial 5 Public water supply 6 Oil field water supply 7 Lawn and garden only 8 Air conditioning 9 Dewatering 10 Observation well 11 Injection well 12 Other (Specify below)

Was a chemical/bacteriological sample submitted to Department? Yes ..... No XXX; If yes, mo/day/yr sample was submitted

Water Well Disinfected? Yes XXX No

5 TYPE OF BLANK CASING USED: 1 Steel 2 PVC 3 RMP (SR) 4 ABS 5 Wrought iron 6 Asbestos-Cement 7 Fiberglass 8 Concrete tile 9 Other (specify below)

CASING JOINTS: Glued XX Clamped Welded Threaded

Blank casing diameter 5 in. to 180 ft., Dia in. to ft., Dia in. to ft.

Casing height above land surface 12 in., weight 200 psi lbs./ft. Wall thickness or gauge No. SDR 21

TYPE OF SCREEN OR PERFORATION MATERIAL: 1 Steel 2 Brass 3 Stainless steel 4 Galvanized steel 5 Fiberglass 6 Concrete tile 7 PVC 8 RMP (SR) 9 ABS 10 Asbestos-cement 11 Other (specify) 12 None used (open hole)

SCREEN OR PERFORATION OPENINGS ARE: 1 Continuous slot 2 Louvered shutter 3 Mill slot 4 Key punched 5 Gauzed wrapped 6 Wire wrapped 7 Torch cut 8 Saw cut 9 Drilled holes 10 Other (specify) 11 None (open hole)

SCREEN-PERFORATED INTERVALS: From 140 ft. to 180 ft., From ft. to ft.

From ft. to ft., From ft. to ft.

GRAVEL PACK INTERVALS: From 15 ft. to 180 ft., From ft. to ft.

From ft. to ft., From ft. to ft.

6 GROUT MATERIAL: 1 Neat cement 2 Cement grout 3 Bentonite 4 Other

Grout Intervals: From 0 ft. to 15 ft., From ft. to ft., From ft. to ft.

What is the nearest source of possible contamination: none

1 Septic tank 2 Sewer lines 3 Watertight sewer lines 4 Lateral lines 5 Cess pool 6 Seepage pit 7 Pit privy 8 Sewage lagoon 9 Feedyard 10 Livestock pens 11 Fuel storage 12 Fertilizer storage 13 Insecticide storage 14 Abandoned water well 15 Oil well/Gas well 16 Other (specify below)

Direction from well? How many feet?

FROM	TO	LITHOLOGIC LOG	FROM	TO	LITHOLOGIC LOG
0	15	Black topsoil & brown clay			
15	120	Brown clay			
120	135	Fine sand & clay mixed			
135	165	Medium to coarse sand			
165	180	Medium to coarse sand & brown clay			

7 CONTRACTOR'S OR LANDOWNER'S CERTIFICATION: This water well was (1) constructed (2) reconstructed, or (3) plugged under my jurisdiction and was completed on (mo/day/year) 8-29-81 and this record is true to the best of my knowledge and belief. Kansas Water Well Contractor's License No. 179 This Water Well Record was completed on (mo/day/yr) March 11, 1982 under the business name of Joe's Well Service, Inc. Cimarron, Ks. by (signature) Larry Crick

INSTRUCTIONS: Use typewriter or ball point pen, *PLEASE PRESS FIRMLY* and *PRINT* clearly. Please fill in blanks, underline or circle the correct answers. Send top three copies to Kansas Department of Health and Environment, Division of Environment, Environmental Geology Section, Topeka, KS 66620. Send one to WATER WELL OWNER and retain one for your records.

OFFICE USE ONLY T 29 R 22 E(W) SEC. 3 SW¼ SW¼ SW¼