

USE TYPEWRITER OR BALL POINT PEN-PRESS FIRMLY, PRINT CLEARLY.

T R EW sec 1/4 1/4 1/4 No.

WATER WELL RECORD  
KSA 82a-1201-1215


Kansas State Dept. Of Health  
(Water Well Contractors)  
Forbes-Bldg. 740  
Topeka, Kansas 66620

CDA

1 Location of well:	County <b>Ford</b>	Township name <b>Sodville</b>	Fracture <b>NE SE SW</b>	Section number <b>3</b>	Town number <b>T 29 S</b>	Range number <b>R 22 W</b>
---------------------	-----------------------	----------------------------------	-----------------------------	----------------------------	------------------------------	-------------------------------

Distance and direction from nearest town or city: **4 Miles west**  
Street address of well location if in city: **1 1/2 Mi. N. Of Bucklin**

3 Owner of well: **Leon Close**  
Address: **Bucklin, Kansas**

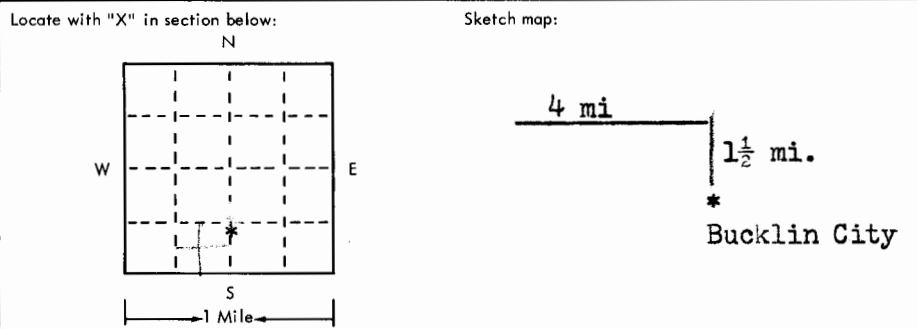

4 Well depth: **185** ft. Date of completion **3-13-75**  
Well diameter **28** in.

5  Cable tool  Rotary  Driven  Dug  
 Hollow rod  Jetted  Bored  Reverse rotary

6 Use:  Domestic  Public supply  Industry  
 Irrigation  Air conditioning  Commercial  
 Test well  \_\_\_\_\_

7 Casing: Material **steel** Height: above ~~2860~~  
Threaded  Welded  Surface **12** in.  
Diam. \_\_\_\_\_ Weight **34** lbs./ft.  
**16** in. to **185** ft. depth Drive shoe?  Yes  No  
\_\_\_\_\_ in. to \_\_\_\_\_ ft. depth

2	Type and color of material	From	To
	<del>XXXX</del> Top soil	0	5
	Clay	5	65
	Sand & clay	65	95
	Sand, fine to fair	95	135
	Sand & gravel, good	135	185
	Shale	185	
	<b>Block 185</b>		
	<b>85' sat thick</b>		
	<b>in Og</b>		
	(use a second sheet if needed)		

8 Screen: Manufacturer **W.A. Brown**  
Type **punch perf.** Dia. **16"**  
Slot/gauze **40 s.p.f** length **60"**  
Set between **145** ft. and **185** ft.  
Fittings: **1/4 x 5/8**  
Gravel pack  Yes  No Size range of material \_\_\_\_\_

9 Static water level: **100** ft. below land surface Date **3-15-75**

10 Pumping level below land surfaces:  
**170** ft. after **2** hrs. pumping **1000** g.p.m.  
\_\_\_\_\_ ft. after \_\_\_\_\_ hrs. pumping \_\_\_\_\_ g.p.m.  
Estimated maximum yield \_\_\_\_\_ g.p.m.

11 Water sample submitted:  
 Yes  No Date \_\_\_\_\_

12 Well head completion:  
 Pitless adapter  Inches above grade **12"**

13 Well grouted?  Yes  No  
 Neat cement  Bentonite  **clay mix**  
Depth: From **0** ft. to **10** ft.

14 Nearest source of possible contamination: **none**  
ft. \_\_\_\_\_ Direction \_\_\_\_\_ Type \_\_\_\_\_  
Well disinfected upon completion?  Yes  No

15 Pump:  Not installed  
Manufacturer's name **Fairbanks Morse**  
Model number **7000** HP **100** Volts \_\_\_\_\_  
Length of drop pipe **160** ft. capacity **1000** m.p.  
Type:  
 Submersible  Turbine  
 Jet  Reciprocating  
 Centrifugal  Other

16 Remarks: elevation

Topography:  
 Hill **Flat**  
 Slope  
 Upland  
 Valley

**2400**  
**108**  
**1285**

17 Water well contractor's certification:  
This well was drilled under my jurisdiction and this report is true to the best of my knowledge and belief.

**Brau Drilling Co** **217**  
Business name License No.  
Address **Bucklin, Kansas**  
Signed **Roland Brau** Date **3-15-75**  
Authorized representative