


1 LOCATION OF WATER WELL:		Fraction	Section Number	Township Number	Range Number
County: Glenn Ford		SW 1/4 SW 1/4 NW 1/4	12	T 29 S	R 22 E/W

Distance and direction from nearest town or city street address of well if located within city?
From Bucklin 3 miles West on Hwy 54 and 1/4 Mile South

2	WATER WELL OWNER:	Sara Hutton Trust c/o Rod Hutton	Waldo Stimpert, Operator
	RR#, St. Address, Box # :	Box 2822	Rt. Board of Agriculture, Division of Water Resources
	City, State, ZIP Code :	Flagstaff, Arizona 86003	Kingsdown, KS Application Number:

3 LOCATE WELL'S LOCATION WITH AN "X" IN SECTION BOX: 4 DEPTH OF COMPLETED WELL: 140. . . . ft. ELEVATION: ft.

Depth(s) Groundwater Encountered 1. . . . ft 2. . . . ft 3. . . . ft

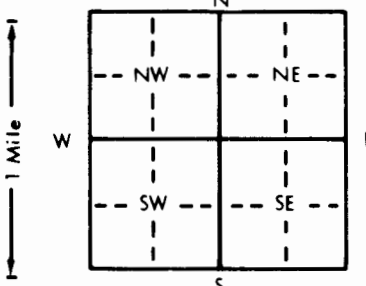

Depth(s) Groundwater Encountered 1. ft. 2. ft. 3. ft.

WELL'S STATIC WATER LEVEL 130 ft. below land surface measured on mo/day/yr

Pump test data: Well water was ft. after hours pumping gpm

Est. Yield gpm: Well water was ft. after hours pumping gpm

Bore Hole Diameter in. to ft., and in. to ft.

WELL WATER TO BE USED AS:

1 <u>Domestic</u>	3 Feedlot	6 Oil field water supply	8 Air conditioning	11 Injection well
2 Irrigation	4 Industrial	7 Lawn and garden only	9 Dewatering	12 Other (Specify below)
			10 Monitoring well

Was a chemical/bacteriological sample submitted to Department? Yes.....No.....; If yes, mo/day/yr sample was submitted

Water Well Disinfected? Yes.....No.....

5 TYPE OF BLANK CASING USED: 1 Steel 3 RMP (SR) 6 Asbestos-Cement 9 Other (specify below) CASING JOINTS: Glued Clamped
2 PVC 4 ABS 7 Fiberglass Welded
Blank casing diameter in. to ft., Dia. in. to ft., Dia. in. to ft.
Casing height above land surface. 48" in. weight lbs./ft. Wall thickness or gauge No.

TYPE OF SCREEN OR PERFORATION MATERIAL:			7 PVC	10 Asbestos-cement
1 Steel	3 Stainless steel	5 Fiberglass	8 RMP (SR)	11 Other (specify) <i>NA</i>
2 Brass	4 Galvanized steel	6 Concrete tile	9 ABS	12 None used (open hole)

SCREEN OR PERFORATION OPENINGS ARE:

1 Continuous slot	3 Mill slot	5 Gauzed wrapped	8 Saw cut	11 None (open hole)
2 Louvered shutter	4 Key punched	6 Wire wrapped	9 Drilled holes	
		7 Torch cut	10 Other (specify) NA	

SCREEN-PERFORATED INTERVALS:	From	N/A	ft. to	N/A	ft., From	ft. to	ft.
	From		ft. to		ft., From	ft. to	ft.
GRAVEL PACK INTERVALS:	From		ft. to		ft., From	ft. to	ft.
	From		ft. to		ft., From	ft. to	ft.

6 GROUT MATERIAL: ¹ Neat cement ² Cement grout ³ Bentonite ⁴ Other _____
Grout Intervals: From ⁴ _____ ft. to ²⁴ _____ ft., From _____ ft. to _____ ft., From _____ ft. to _____ ft.

What is the nearest source of possible contamination:

1 Septic tank	4 Lateral lines	7 Pit privy	10 Livestock pens	14 Abandoned water well
2 Sewer lines	5 Cess pool	8 Sewage lagoon	11 Fuel storage	15 Oil well/Gas well
3 Watertight sewer lines	6 Seepage pit	9 Feedyard	12 Fertilizer storage	16 Other (specify below)
			13 Insecticide storage	<i>NONE</i>

Direction from well?			How many feet?		
FROM	TO	LITHOLOGIC LOG	FROM	TO	PLUGGING INTERVALS

			4'	24'	Bentonite Hole Plug
			24'	130'	Dirt
			130'	140'	Sand

7 CONTRACTOR'S OR LANDOWNER'S CERTIFICATION: This water well was (1) constructed, (2) reconstructed, or (3) plugged under my jurisdiction and was completed on (mo/day/year) March 26, 1993 and this record is true to the best of my knowledge and belief. Kansas Water Well Contractor's License No. This Water Well Record was completed on (mo/day/yr) April 2, 1993 under the business name of Friesen Windmill & Supply Inc. by (signature) [Signature]