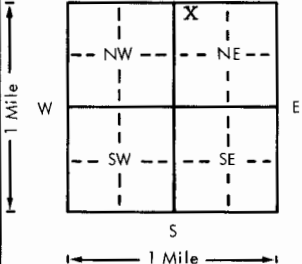


USE TYPEWRITER OR BALL
POINT PEN-PRESS FIRMLY,
PRINT CLEARLY.

WATER WELL RECORD
KSA 82a-1201-1215

Kansas Department of Health and
Environment-Division of Environment
(Water well Contractors)
Topeka, Kansas 66620


1. Location of well:		County Ford	Fraction NW 1/4 NW 1/4	Section number 14	Township number T 29 S	Range number R 22
2. Distance and direction from nearest town or city: 2 1/2 W, 1 S of Bucklin Street address of well location if in city:				3. Owner of well: Rod Hutton R.R. or street: Bucklin, Ks. 67834 City, state, zip code:		
4. Locate with "X" in section below: N  S 1 Mile				Sketch map:		
5. Type and color of material				From	To	
Surface				0	2	
Clay				2	112	
Caliche				112	114	
Clay				114	115	
Caliche & Clay				115	128	
Medium Sand				128	131	
Clay				131	132	
Medium Sand				132	139	
Hard Layer				139	140	
Medium-Fine Sand				140	146	
Medium Sand & Gravel				146	149	
Medium Sand				149	161	
Medium Sand & Gravel				161	177	
Coarse Gravel				177	179	
Medium Sand & Gravel				179	189	
continued on page 2 (Use a second sheet if needed)						
18. Elevation:		19. Remarks:		20. Water well contractor's certification: This well was drilled under my jurisdiction and this report is true to the best of my knowledge and belief. Woofter Drilling Inc. 343 Business name License No. Address Hwy 56 Dodge City, Ks. Signed Michael D. Woofter Date 12/11/14 Authorized representative		
Topography: <input type="checkbox"/> Hill <input type="checkbox"/> Slope <input checked="" type="checkbox"/> Upland <input type="checkbox"/> Valley						

27 220 14
T
R
Sec
1/4 1/4 1/4

USE TYPEWRITER OR BALL
POINT PEN-PRESS FIRMLY,
PRINT CLEARLY.

WATER WELL RECORD
KSA 82a-1201-1215

Kansas Department of Health and
Environment-Division of Environment
(Water well Contractors)
Topeka, Kansas 66620

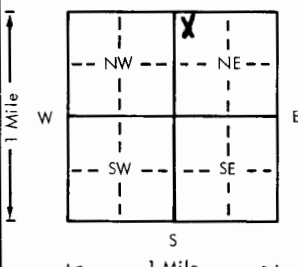1. Location of well:		County Ford	Fraction NW 1/4 NW 1/4 NE 1/4	Section number 14	Township number T 29 S R 22 E	Range number 22		
2. Distance and direction from nearest town or city: Street address of well location if in city:			3. Owner of well: Rod Hutton (page 2) R.R. or street: Bucklin, Ks. City, state, zip code:					
4. Locate with "X" in section below: N  W S E 1 Mile 1 Mile			Sketch map:			6. Bore hole dia. _____ in. Completion date _____ Well depth _____ ft.		
5. Type and color of material			From	To	7. Cable tool _____ Rotary _____ Driven _____ Dug _____ Hollow rod _____ Jetted _____ Bored _____ Reverse rotary			
			Fine Sand		189	191	8. Use: _____ Domestic _____ Public supply _____ Industry _____ Irrigation _____ Air conditioning _____ Stock _____ Lawn _____ Oil field water _____ Other	
			Medium Sand		191	194	9. Casing: Material _____ Height: Above or below Threaded _____ Welded _____ Surface _____ in. RMP _____ PVC _____ Weight _____ lbs./ft.	
			Ochre		194	199	Dia. _____ in. to _____ ft. depth Wall Thickness: inches or Dia. _____ in. to _____ ft. depth gage No. _____	
							10. Screen: Manufacturer's name _____ Type _____ Dia. _____ Slot/gauze _____ Length _____ Set between _____ ft. and _____ ft. _____ ft. and _____ ft.	
							Gravel pack? _____ Size range of material _____	
							11. Static water level: _____ mo./day/yr. _____ ft. below land surface Date _____	
							12. Pumping level below land surfaces: _____ ft. after _____ hrs. pumping _____ g.p.m. _____ ft. after _____ hrs. pumping _____ g.p.m. Estimated maximum yield _____ g.p.m.	
							13. Water sample submitted: _____ mo./day/yr. _____ Yes _____ No Date _____	
							14. Well head completion: _____ Pitless adapter _____ Inches above grade	
				15. Well grouted? _____ With: _____ Neat cement _____ Bentonite _____ Concrete Depth: From _____ ft. to _____ ft.				
				16. Nearest source of possible contamination: ft. _____ Direction _____ Type _____ Well disinfected upon completion? _____ Yes _____ No				
				17. Pump: _____ Not installed Manufacturer's name _____ Model number _____ HP _____ Volts _____ Length of drop pipe _____ ft. capacity _____ g.p.m. Type: _____ Submersible _____ Turbine _____ Jet _____ Reciprocating _____ Centrifugal _____ Other				
(Use a second sheet if needed)								
18. Elevation: Topography: _____ Hill _____ Slope _____ Upland _____ Valley		19. Remarks:		20. Water well contractor's certification: This well was drilled under my jurisdiction and this report is true to the best of my knowledge and belief. Woofter Drilling Inc. 343 Business name License No. Address Hwy 56, Dodge City, Ks. Signed M. Schell Date 12/1/12 Authorized representative				