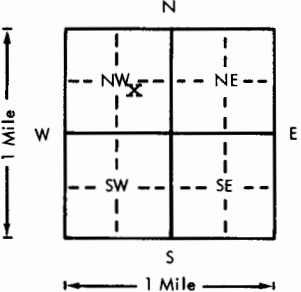


USE TYPEWRITER OR BALL  
POINT PEN-PRESS FIRMLY,  
PRINT CLEARLY.

WATER WELL RECORD  
KSA 82a-1201-1215

Kansas Department of Health and  
Environment-Division of Environment  
(Water well Contractors)  
Topeka, Kansas 66620

1. Location of well:		County <b>Ford</b>	Fraction <b>NW 1/4 SE 1/4 NW 1/4</b>	Section number <b>16</b>	Township number <b>T 29 S R 22 E</b>	Range number <b>22</b>	
2. Distance and direction from nearest town or city: Street address of well location if in city: <b>1 Mile east, 1/2 s of Kingsdown,</b>			3. Owner of well: <b>Waldo Stimpert</b> R.R. or street: <b>R.R.</b> City, state, zip code: <b>Kingsdown, Kansas</b>				
4. Locate with "X" in section below:		Sketch map: 		Well located near TH 3-75 which is in the center of the NW 1/4, Sec. 16, T29S, R22W, Ford County, Kansas.			
5. Type and color of material			From	To	6. Bore hole dia. <b>16</b> in. Completion date <b>11-5-75</b> Well depth <b>196</b> ft.		
Top soil			0	3	7. Cable tool <input type="checkbox"/> Rotary <input type="checkbox"/> Driven <input type="checkbox"/> Dug Hollow rod <input type="checkbox"/> Jetted <input type="checkbox"/> Bored <input checked="" type="checkbox"/> Reverse rotary		
Tan clay			3	130	8. Use: Domestic <input type="checkbox"/> Public supply <input type="checkbox"/> Industry <input checked="" type="checkbox"/> Irrigation <input type="checkbox"/> Air conditioning <input type="checkbox"/> Stock Lawn <input type="checkbox"/> Oil field water <input type="checkbox"/> Other		
Tan clay and caliche streaks			130	156	9. Casing: Material <b>steel</b> Weight: <b>Above or below</b> Threaded <input type="checkbox"/> Welded <input checked="" type="checkbox"/> Surface <b>12</b> in. RMP <input type="checkbox"/> PVC <input type="checkbox"/> Weight <b>39</b> lbs./ft. Dia. <b>16</b> in. to <b>156</b> ft. depth Wall Thickness: inches or Dia. <input type="checkbox"/> in. to <input type="checkbox"/> ft. depth Gauge No. <b>219</b>		
Coarse sand fine gravel			156	187	10. Screen: Manufacturer's name <b>Layne &amp; Doerr</b> Type <b>louver</b> Dia. <b>16</b> " Slot/gauze <b>1/8</b> " Length <b>40</b> " Set between <b>156</b> ft. and <b>196</b> ft. Gravel pack? <b>yes</b> Size range of material <b>2.5-9.2mm</b>		
Coarse sand fine to medium gravel			187	196	11. Static water level: <b>120</b> ft. below land surface Date <b>10-22-75</b> mo./day/yr.		
Black shale			196	220	12. Pumping level below land surfaces: <b>160</b> ft. after <b>1/2</b> hrs. pumping <b>1040</b> g.p.m. <b>336</b> ft. after <b>1</b> hrs. pumping <b>1336</b> g.p.m. Estimated maximum yield <b>1200</b> g.p.m.		
					13. Water sample submitted: <b>Yes</b> <input checked="" type="checkbox"/> No <input type="checkbox"/> Date		
					14. Well head completion: Pitless adapter <input checked="" type="checkbox"/> Inches above grade		
					15. Well grouted? <input checked="" type="checkbox"/> With: <input type="checkbox"/> Neat cement <input checked="" type="checkbox"/> Bentonite <input type="checkbox"/> Concrete Depth: From <b>0</b> ft. to <b>10</b> ft.		
					16. Nearest source of possible contamination: <b>unk</b> ft. Direction Type Well disinfected upon completion? <input checked="" type="checkbox"/> Yes <input type="checkbox"/> No		
					17. Pump: <b>Not installed</b> Manufacturer's name <b>Layne &amp; Bowler</b> Model number <b>12K</b> HP <b>100</b> Volts Length of drop pipe <b>180</b> ft. capacity <b>800</b> g.p.m. Type: <input type="checkbox"/> Submersible <input checked="" type="checkbox"/> Turbine <input type="checkbox"/> Jet <input type="checkbox"/> Reciprocating <input type="checkbox"/> Centrifugal <input type="checkbox"/> Other		
(Use a second sheet if needed)							
18. Elevation:		19. Remarks:		20. Water well contractor's certification: This well was drilled under my jurisdiction and this report is true to the best of my knowledge and belief. <b>Layne-Western Co., Inc. 150</b> Business name License No. Address <b>Garden City, Kansas</b> Signed <b>R. J. Stimpert</b> Date <b>2 Dec 75</b> Authorized representative			
Topography: <input type="checkbox"/> Hill <input type="checkbox"/> Slope <input checked="" type="checkbox"/> Upland <input type="checkbox"/> Valley							

29 220 16 NW SE NW  
T 29 S R 22 E