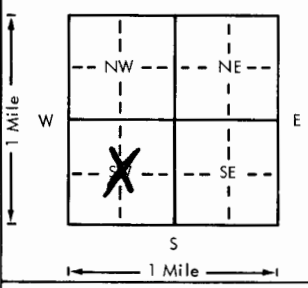


USE TYPEWRITER OR BALL
POINT PEN-PRESS FIRMLY,
PRINT CLEARLY.

WATER WELL RECORD
KSA 82a-1201-1215

Kansas Department of Health and
Environment-Division of Environment
(Water well Contractors)
Topeka, Kansas 66620

1. Location of well:		County FORD	Fraction C 1/4 C 1/4 SW 1/4	Section number 23	Township number T 24 S R 22 E (W)	Range number
2. Distance and direction from nearest town or city: 2 mi S-3 mi E		3. Owner of well: M & M PAUL JENKINS				
Street address of well location if in city: OF KINGS DOWN, KS		R.R. or street: Bucklin, KS 67834				
City, state, zip code:						
4. Locate with "X" in section below:		Sketch map:		6. Bore hole dia: 30 in. Completion date Well depth 208 ft. 4-19-83		
				7. <input type="checkbox"/> Cable tool <input type="checkbox"/> Rotary <input type="checkbox"/> Driven <input type="checkbox"/> Dug <input type="checkbox"/> Hollow rod <input type="checkbox"/> Jetted <input type="checkbox"/> Bored <input checked="" type="checkbox"/> Reverse rotary		
5. Type and color of material		From		To		8. Use: <input checked="" type="checkbox"/> Domestic <input type="checkbox"/> Public supply <input type="checkbox"/> Industry <input checked="" type="checkbox"/> Irrigation <input type="checkbox"/> Air conditioning <input type="checkbox"/> Stock <input type="checkbox"/> Lawn <input type="checkbox"/> Oil field water <input type="checkbox"/> Other
TOP SOIL		0		5		9. Casing: Material STEEL Height: Above or below Threaded <input type="checkbox"/> Welded <input checked="" type="checkbox"/> Surface 12 in. RMP <input type="checkbox"/> PVC <input type="checkbox"/> Weight <input type="checkbox"/> lbs./ft. Dia 16 in. to 148 ft. depth Wall Thickness inches Dia. <input type="checkbox"/> in. to <input type="checkbox"/> ft. depth gage No. 188"
CLAY		01		5		10. Screen Manufacturer's name DOERR METAL Type Steel Dia. 16" Slot/gauze <input type="checkbox"/> Length 60' Set between 148 ft. and 208 ft. ft. and <input type="checkbox"/> Gravel pack? <input checked="" type="checkbox"/> Size range of material 1/4-5/8
SAND AND GRAVEL		17		115		11. Static water level: <input type="checkbox"/> mo./day/yr. 120 ft. below land surface Date 1-19-83
CLAY		01		125		12. Pumping level below land surfaces: 120 ft. after 2 hrs. pumping 1400 g.p.m. ft. after <input type="checkbox"/> hrs. pumping <input type="checkbox"/> g.p.m. Estimated maximum yield 1400 g.p.m.
SAND AND GRAVEL		17		140		13. Water sample submitted: <input type="checkbox"/> Yes <input checked="" type="checkbox"/> No Date <input type="checkbox"/>
SHALE		19		208		14. Well head completion: 12 inches above grade <input type="checkbox"/> Pitless adapter
						15. Well grouted? <input type="checkbox"/> With: <input type="checkbox"/> Neat cement <input type="checkbox"/> Bentonite <input type="checkbox"/> Concrete Depth: From <input type="checkbox"/> ft. to <input type="checkbox"/> ft.
						16. Nearest source of possible contamination: N/A ft. <input type="checkbox"/> Direction <input type="checkbox"/> Type <input type="checkbox"/> Well disinfected upon completion? <input checked="" type="checkbox"/> Yes <input type="checkbox"/> No
						17. Pump: <input checked="" type="checkbox"/> Not installed Manufacturer's name <input type="checkbox"/> Model number <input type="checkbox"/> HP <input type="checkbox"/> Volts <input type="checkbox"/> Length of drop pipe <input type="checkbox"/> ft. capacity <input type="checkbox"/> g.p.m. Type: <input type="checkbox"/> Submersible <input type="checkbox"/> Turbine <input type="checkbox"/> Jet <input type="checkbox"/> Reciprocating <input type="checkbox"/> Centrifugal <input type="checkbox"/> Other
						20. Water well contractor's certification: This well was drilled under my jurisdiction and this report is true to the best of my knowledge and belief. BRAH DRILLING INC 217 Business name Bucklin KS License No. <input type="checkbox"/> Address Enbrian Date 1-31-83 Signed <input type="checkbox"/> Authorized representative
18. Elevation:		19. Remarks:				
Topography: <input checked="" type="checkbox"/> Hill <input checked="" type="checkbox"/> Slope <input type="checkbox"/> Upland <input type="checkbox"/> Valley						