

COPY

Ford NW NE SW
9-29-22W

Suite 700 • 155 North Market • Wichita, Kansas 67202-1821
(316) 262-3573

October 13, 2011

Kansas Department of Health and Environment
Division of Environment
Geology Section
Bureau of Water
1000 SW Jackson St., Suite 420
Topeka, Kansas 66612-1367

Attn: Mr. Richard Harper, LG

Ref: Water Appropriation -Temporary Permit # 20110216 00
Assignment of Water Well to Landowner
NW-NE-SW 9-29-22W
Ford Co., Kansas

Dear Mr. Harper:

Enclosed for your files are a number of documents relative to the above referenced water well which was drilled by Rosencrantz-Bemis (KWWCL#134) on behalf of Vincent Oil Corporation.
The well was drilled in May of 2011 as a water supply well for an oil well drilling operation.

The landowner of the property on which the well is located has elected to assume responsibility for the water well under existing Kansas law and / or regulation.

Towards that end I have attached the following for your records:

1. A copy of the Water Well Record (Form WWC-5)
2. A copy of the Water Appropriation - Temporary Permit # 20110216 00
3. A signed original Assignment of Water Well to Landowner (KDHW Form WWC-7)

After reviewing the enclosed documentation should you have any questions or require additional information to complete this transfer please contact me at your earliest convenience. I can be reached at the address and or telephone number shown in the above letterhead.

Sincerely,

M.L. Korphage, P.G.
Geologist
Vincent Oil Corporation

XC: File

RECEIVED
OCT 14 2011
BUREAU OF WATER

20110216

Check: ☐ White Copy, ☐ Blue Copy, ☐ Pink Copy

Submit To:

CHIEF ENGINEER
Division of Water Resources
Kansas Department of Agriculture
109 SW 9th Street, 2nd Floor
Topeka, KS 66612-1283
www.ksda.gov/dwr

APPLICATION FOR
TEMPORARY PERMIT

☒ GROUNDWATER
☐ SURFACE WATER
(check one)

WATER RESOURCES
RECEIVED

MAY 13 2011

12:54 PM



KS DEPT OF AGRICULTURE

FO 2
GMD 3
MEETS 9
K.A.R. 5-1
BY KAT
DATE May 13 2011

STATUTORY FILING FEE OF \$200.00 MUST ACCOMPANY THIS APPLICATION
(Make check payable to the Kansas Department of Agriculture)

20110216

1. Applicant: (Please print or type)

Name Vincent Oil Co.
Street 90 Rosencrantz - Benis
City and State P.O. Box 713 Great Bend, KS
Zip Code 67530
Social Security I.D. #
and/or Taxpayer I.D. #

6. Period of use (6 months maximum):

Commencing date: May 19, 2011
Ending Date: Nov. 18, 2011 * July 1, 2011

7. Location of the proposed point of diversion shall be indicated on the diagram below. Use the center section.

If surface water, indicate on the diagram the course of the stream, and its name.

The scale of the diagram is 2 inches = 1 mile
Each small square represents 10 acres

2. Location of Point of Diversion:

Sec. 9, Twp. 29, Rng. 22, (NW),
Ford County, Kansas.

Distance from Southeast Corner of Section:

2130 feet North from Southeast Corner
3450 feet West from Southeast Corner

Existing water right? Yes ☐ No ☒
If yes, File No. _____

Pending application? Yes ☐ No ☒
If yes, File No. _____

3. Water Use Data:


Proposed Max. Pumping Rate (gpm) 40 GPM
Amount Requested (gallons) 1/2 million
(not to exceed one million gallons unless for dewatering)
Depth of Well (feet) 200 ft. OR
Name of Stream _____

4. Water is to be used for (briefly describe proposed use):


Drilling oil well

5. Location of place of use:

SE1NW1NE1SW
9-29-22
Ford County

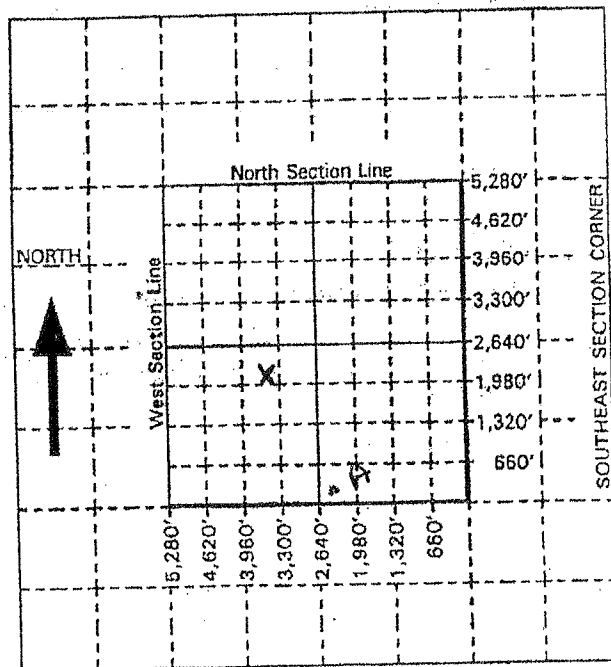

For Office Use Only: Code TMP Fee \$ 200 TR # _____ Receipt Date 5/13/11 Check # 450

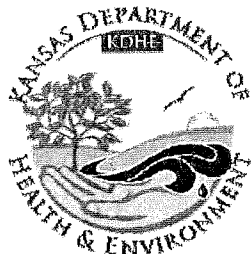

KANSAS DEPARTMENT OF HEALTH & ENVIRONMENT

ASSIGNMENT OF WATER WELL TO LANDOWNER

I, Larry K Feikert of 321 Main Street
(Landowner's address)

Bucklin Kansas 67834 am the landowner on which a water well is located in
(City) (State) (Zip)
the NW quarter of the NE quarter of the SW quarter in Section 9, Township 29,
Range 22 ☐ E ☒ W, in Ford County, Kansas which is approxi-
mately 2130 feet north/~~south~~, and 3450 feet ~~east~~/west of the apparent SE
section corner. The water well was drilled in May 2011 (month/year).

I hereby request that Vincent Oil Corporation leave the water well,
(Operator name)
which was drilled by Temporary Water Permit # 20110216, unplugged, and I will
assume all responsibility for the plugging of said water well in accordance with the requirements
of the Kansas Department of Health and Environment regulation K.A.R. 28-30-7.

LANDOWNER:

x Larry K Feikert 8-8-11
(Signature) (Date)

x Larry K Feikert
(Print)

IF ADDITIONAL LANDOWNER

(Signature) (Date)

(Print)

WWC-7

OPERATOR:

M. L. Korphage 8/8/2011
(Signature) (Date)

By: M. L. Korphage, P.G.
(Agent)
Vincent Oil Corporation