

WATER WELL RECORD


Form WWC-5

Division of Water Resources App. No.

20140981

1 LOCATION OF WATER WELL: County: Ford, Fraction 1/4 NW 1/4 NE 1/4 SE 1/4, Section Number 6, Township No. T 29 S, Range Number R 22, Global Positioning System (GPS) information: Latitude, Longitude, Elevation, Datum, Collection Method.

2 WATER WELL OWNER: Vincent Oil Corp, RR#, Street Address, Box #: 155 N. Market- Ste 700, City, State, ZIP Code : Wichita, KS 67202

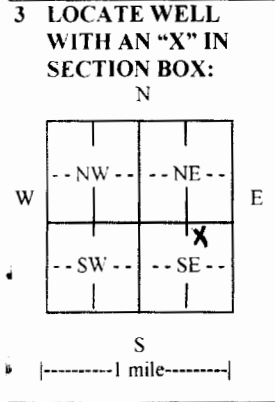

3 LOCATE WELL WITH AN 'X' IN SECTION BOX: 4 DEPTH OF COMPLETED WELL 247 ft. Depth(s) Groundwater Encountered (1) 192 ft. (2) ft. (3) ft. WELL'S STATIC WATER LEVEL 192 ft. below land surface measured on mo/day/yr. 11-8-14. Pump test data: Well water was... EST. YIELD N/A gpm. Well water was... Bore Hole Diameter 10 in. to 247 ft., and... WELL WATER TO BE USED AS: Public water supply, Domestic, Irrigation, Industrial, Oil field water supply, Dewatering, Monitoring well, Geothermal, Injection well, Other (Specify below). Was a chemical/bacteriological sample submitted to Department? Yes No. If yes, mo/day/yr sample was submitted. Water well disinfected? Yes No.

5 TYPE OF CASING USED: Steel PVC Other. CASING JOINTS: Glued Clamped Welded Threaded. Casing diameter 5 in. to 247 ft., Diameter in. to ft., Diameter in. to ft. Casing height above land surface 18 in., Weight SDR-26 lbs./ft., Wall thickness or gauge No. TYPE OF SCREEN OR PERFORATION MATERIAL: Steel Stainless Steel PVC Other (Specify) Brass Galvanized Steel None used (open hole). SCREEN OR PERFORATION OPENINGS ARE: Continuous slot Mill slot Gauze wrapped Torch cut Drilled holes None (open hole) Louvered shutter Key punched Wire wrapped Saw cut Other (specify). SCREEN-PERFORATED INTERVALS: From 247 ft. to 207 ft., From ft. to ft. GRAVEL PACK INTERVALS: From 247 ft. to 20 ft., From ft. to ft.

6 GROUT MATERIAL: Neat cement Cement grout Bentonite Other. Grout Intervals: From ft. to ft., From 20 ft. to 0 ft., From ft. to ft. What is the nearest source of possible contamination: Septic tank Lateral lines Pit privy Livestock pens Insecticide storage Other (specify below) Sewer lines Cesspool Sewage lagoon Fuel storage Abandoned water well Watertight sewer lines Seepage pit Feedyard Fertilizer storage Oil well/gas well. Direction from well North Distance from well 1000ft.

Table with columns: FROM, TO, LITHOLOGIC LOG, FROM, TO, LITHO. LOG (cont.) or PLUGGING INTERVALS. Rows: 0-4 Top soil, 4-173 Tan clay & caliche, 173-236 Sand & gravel- med, tight, 236-247 Gray shale.

7 CONTRACTOR'S OR LANDOWNER'S CERTIFICATION: This water well was constructed, reconstructed, or plugged under my jurisdiction and was completed on (mo/day/year) 11-8-14 and this record is true to the best of my knowledge and belief. Kansas Water Well Contractor's License No. 134. This Water Well Record was completed on (mo/day/year) 11-25-14 under the business name of Rosencrantz- Bemis Ent Inc by (signature) Sara A. Bemis.

INSTRUCTIONS: Use typewriter or ball point pen. PLEASE PRESS FIRMLY and PRINT clearly. Please fill in blanks and check the correct answers. Send three copies (white, blue, pink) to Kansas Department of Health and Environment, Bureau of Water, Geology Section, 1000 SW Jackson St., Suite 420, Topeka, Kansas 66612-1367. Telephone 785-296-5524. Send one copy to WATER WELL OWNER and retain one for your records. Include fee of \$5.00 for each constructed well. Visit us at http://www.kdheks.gov/waterwell/index.html.