


1 LOCATION OF WATER WELL:	Fraction	Section Number	Township Number	Range Number
County: <u>Ford</u>	<u>SE 1/4 SE 1/4 SE 1/4</u>	<u>24</u>	T <u>29</u> S	R <u>22</u> E <u>W</u>

Distance and direction from nearest town or city street address of well if located within city?

From Bucklin, 3 miles south on Hwy. 34 then 2 miles west.

2 WATER WELL OWNER: <u>Mark Davis</u>	Board of Agriculture, Division of Water Resources
RR#, St. Address, Box #: <u>12795 130 Rd</u>	Application Number:
City, State, ZIP Code: <u>Bucklin, KS 67834</u>	

3 LOCATE WELL'S LOCATION WITH AN "X" IN SECTION BOX:	4 DEPTH OF COMPLETED WELL: <u>172'</u> ft. ELEVATION:
------------------------------------------------------	-------------------------------------------------------

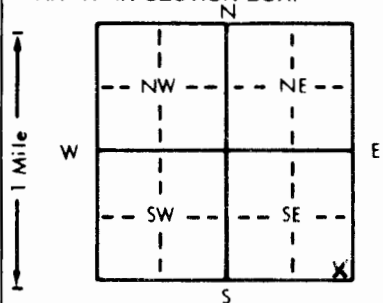

Depth(s) Groundwater Encountered 1. ft. 2. ft. 3. ft.

WELL'S STATIC WATER LEVEL 95' ft. below land surface measured on mo/day/yr 10-19-94

Pump test data: Well water was ft. after hours pumping gpm

Est. Yield gpm: Well water was ft. after hours pumping gpm

Bore Hole Diameter: 9 7/8" in. to ft. and in. to ft.

WELL WATER TO BE USED AS: 5 Public water supply 8 Air conditioning 11 Injection well

1 Domestic 3 Feedlot 6 Oil field water supply 9 Dewatering 12 Other (Specify below)

2 Irrigation 4 Industrial 7 Lawn and garden only 10 Monitoring well

Was a chemical/bacteriological sample submitted to Department? Yes No X If yes, mo/day/yr sample was sub-mitted Water Well Disinfected? Yes X No

5 TYPE OF BLANK CASING USED:	5 Wrought iron	8 Concrete tile	CASING JOINTS: Glued <u>X</u> Clamped
------------------------------	----------------	-----------------	---------------------------------------

1 Steel 3 RMP (SR) 6 Asbestos-Cement 9 Other (specify below) Welded

2 PVC 4 ABS 7 Fiberglass ThreadedBlank casing diameter 5" in. to 172' ft. Dia in. to ft. Dia in. to ft.Casing height above land surface 36' in. weight lbs./ft. Wall thickness or gauge No. SDR 21TYPE OF SCREEN OR PERFORATION MATERIAL: 7 PVC 10 Asbestos-cement

1 Steel 3 Stainless steel 5 Fiberglass 8 RMP (SR) 11 Other (specify)

2 Brass 4 Galvanized steel 6 Concrete tile 9 ABS 12 None used (open hole)

SCREEN OR PERFORATION OPENINGS ARE: 5 Gauzed wrapped 8 Saw cut 11 None (open hole)

1 Continuous slot 3 Mill slot 6 Wire wrapped 9 Drilled holes

2 Louvered shutter 4 Key punched 7 Torch cut 10 Other (specify)

SCREEN-PERFORATED INTERVALS: From 172' ft. to 192' ft. From ft. to ft.

From ft. to ft. From ft. to ft.

GRAVEL PACK INTERVALS: From 24' ft. to 192' ft. From ft. to ft.

From ft. to ft. From ft. to ft.

6 GROUT MATERIAL:	1 Neat cement	2 Cement grout	<u>3 Bentonite</u>	4 Other
-------------------	---------------	----------------	--------------------	---------

Grout Intervals: From ft. to ft. From ft. to ft. From ft. to ft.

What is the nearest source of possible contamination: 10 Livestock pens 14 Abandoned water well

1 Septic tank 4 Lateral lines 7 Pit privy 11 Fuel storage 15 Oil well/Gas well

2 Sewer lines 5 Cess pool 8 Sewage lagoon 12 Fertilizer storage 16 Other (specify below)

3 Watertight sewer lines 6 Seepage pit 9 Feedyard 13 Insecticide storage

Direction from well? North How many feet? 50'

FROM	TO	LITHOLOGIC LOG	FROM	TO	PLUGGING INTERVALS
0	1	Topsoil			
1	38	Brown clay			
38	79	Brown clay & Caliche layers			
79	120	Med. sand, sandrock ledges & brown clay layers			
120	122	Brown clay			
122	125	Med. sand			
125	140	Brown clay			
140	190	Med. sand			
190	192	Shale			

7 CONTRACTOR'S OR LANDOWNER'S CERTIFICATION: This water well was <u>(1) constructed</u> , <u>(2) reconstructed</u> , or <u>(3) plugged</u> under my jurisdiction and was completed on (mo/day/year) <u>10-19-94</u> and this record is true to the best of my knowledge and belief. Kansas

Water Well Contractor's License No. 533 This Water Well Record was completed on (mo/day/yr) 11-2-94under the business name of Jensen Water Well Repair by (signature) [Signature]