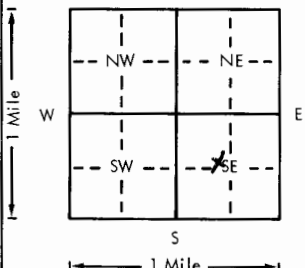


USE TYPEWRITER OR BALL
POINT PEN-PRESS FIRMLY,
PRINT CLEARLY.

WATER WELL RECORD
KSA 82a-1201-1215

Kansas Department of Health and
Environment-Division of Environment
(Water well Contractors)
Topeka, Kansas 66620

1. Location of well:		County Ford	Fraction SE 1/4 NW 1/4 SE 1/4	Section number 4	Township number T 29 S R 23 E	Range number 23
2. Distance and direction from nearest town or city: Approximately 5 3/4 miles SW of Ford, Kansas.			3. Owner of well: Gorden Barnhardt R.R. or street: Bucklin, Kansas 67834 City, state, zip code:			
4. Locate with "X" in section below: 			Sketch map:			6. Bore hole dia. 26 in. Completion date 10/12/78 Well depth 286 ft.
5. Type and color of material			From	To	7. <input type="checkbox"/> Cable tool <input type="checkbox"/> Rotary <input type="checkbox"/> Driven <input type="checkbox"/> Dug <input type="checkbox"/> Hollow rod <input type="checkbox"/> Jetted <input type="checkbox"/> Bored <input checked="" type="checkbox"/> Reverse rotary	
See Attachment					8. Use: <input type="checkbox"/> Domestic <input type="checkbox"/> Public supply <input type="checkbox"/> Industry <input checked="" type="checkbox"/> Irrigation <input type="checkbox"/> Air conditioning <input type="checkbox"/> Stock <input type="checkbox"/> Lawn <input type="checkbox"/> Oil field water <input type="checkbox"/> Other	
					9. Casing: Material Steel Height: (Above) or below Threaded <input type="checkbox"/> Welded <input checked="" type="checkbox"/> Surface 12 in. RMP <input type="checkbox"/> PVC <input type="checkbox"/> Weight 36.91 lbs./ft. Dia. 16 in. to 286 ft. depth Wall Thickness: inches or Dia. <input type="checkbox"/> in. to <input type="checkbox"/> ft. depth gage No. .219	
					10. Screen: Manufacturer's name Johnson Screen Type Continuous Dia. 16" Slo/gauze .100 Length 40' Set between 225 ft. and 265 ft. Yes ft. and <input type="checkbox"/> ft. Gravel pack? <input type="checkbox"/> Size range of material #1 Coarse	
					11. Static water level: <input type="checkbox"/> mo./day/yr. 176 ft. below land surface Date 10/16/78	
					12. Pumping level below land surfaces: 207 ft. after <input type="checkbox"/> hrs. pumping 1444 g.p.m. <input type="checkbox"/> ft. after <input type="checkbox"/> hrs. pumping <input type="checkbox"/> g.p.m. Estimated maximum yield 1,500 g.p.m.	
					13. Water sample submitted: <input type="checkbox"/> mo./day/yr. <input type="checkbox"/> Yes <input checked="" type="checkbox"/> No Date <input type="checkbox"/>	
					14. Well head completion: <input type="checkbox"/> Pitless adapter 12 Inches above grade	
					15. Well grouted? Yes With: <input type="checkbox"/> Neat cement <input checked="" type="checkbox"/> Bentonite <input type="checkbox"/> Concrete Depth: From 0 ft. to 10 ft.	
					16. Nearest source of possible contamination: None ft. <input type="checkbox"/> Direction <input type="checkbox"/> Type Observed Well disinfected upon completion? <input type="checkbox"/> Yes <input checked="" type="checkbox"/> No	
					17. Pump: <input checked="" type="checkbox"/> Not installed Manufacturer's name <input type="checkbox"/> Model number <input type="checkbox"/> HP <input type="checkbox"/> Volts <input type="checkbox"/> Length of drop pipe <input type="checkbox"/> ft. capacity <input type="checkbox"/> g.p.m. Type: <input type="checkbox"/> Submersible <input type="checkbox"/> Turbine <input type="checkbox"/> Jet <input type="checkbox"/> Reciprocating <input type="checkbox"/> Centrifugal <input type="checkbox"/> Other	
18. Elevation: x Flat Topography: <input type="checkbox"/> Hill <input type="checkbox"/> Slope <input type="checkbox"/> Upland <input type="checkbox"/> Valley			19. Remarks: 2551 (TOPO) 106' sat there			20. Water well contractor's certification: This well was drilled under my jurisdiction and this report is true to the best of my knowledge and belief. Henkle Drilling & Sply 145 Business name License No. Address Box 639, Garden City, KS Signed Bruce J. Reichardt 10/17/78 Authorized representative

DRILLERS TEST LOG

CUSTOMERS NAME Gordon Barnhardt DATE 9/19/78
STREET ADDRESS _____ TEST # 2 E. LOG Yes
CITY & STATE Bucklin, Kansas DRILLER Rector
COUNTY Ford QUARTER SE SECTION 4 TOWNSHIP 29 RANGE 23
LOCATION 75 ft NW of the Pivot.

[illegible]

GARDEN CITY, KS
Phone 276-3278

HENKLE DRILLING & SUPPLY CO., INC.
IRRIGATION HEADQUARTERS

SUBLETTE, KS
Phone 675-4311

TEST HOLES * * * * * IRRIGATION & INDUSTRIAL WELLS * * * * STOCK WELLS