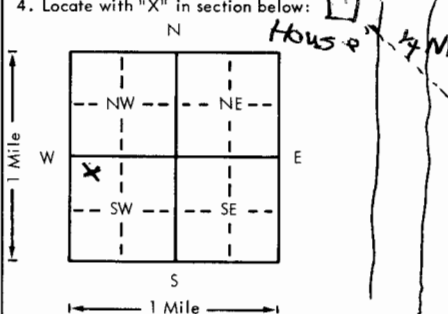


USE TYPEWRITER OR BALL
POINT PEN-PRESS FIRMLY,
PRINT CLEARLY.

WATER WELL RECORD
KSA 82a-1201-1215

Kansas Department of Health and
Environment-Division of Environment
(Water well Contractors)
Topeka, Kansas 66620

1. Location of well:		County FORD	Fraction NW 1/4 SW 1/4	Section number 25	Township number T 29 S	Range number R 23 E	
2. Distance and direction from nearest town or city: 3W 38 KINGSDOWN Kansas			3. Owner of well: Kenneth White R.R. or street: KINGSDOWN, Kansas City, state, zip code:	
4. Locate with "X" in section below: 			6. Bore hole dia. 8 3/4 in. Completion date 12-21-77 Well depth 180 ft.	
5. Type and color of material			7. <input checked="" type="checkbox"/> Cable tool <input checked="" type="checkbox"/> Rotary <input type="checkbox"/> Driven <input type="checkbox"/> Dug <input type="checkbox"/> Hollow rod <input type="checkbox"/> Jetted <input type="checkbox"/> Bored <input type="checkbox"/> Reverse rotary	
			8. Use: <input type="checkbox"/> Domestic <input type="checkbox"/> Public supply <input type="checkbox"/> Industry <input type="checkbox"/> Irrigation <input type="checkbox"/> Air conditioning <input checked="" type="checkbox"/> Stock <input type="checkbox"/> Lawn <input type="checkbox"/> Oil field water <input type="checkbox"/> Other	
			9. Casing: Material <input type="checkbox"/> Height: Above or below Threaded <input type="checkbox"/> Welded <input type="checkbox"/> Surface 20 in. RMP <input checked="" type="checkbox"/> PVC <input type="checkbox"/> Weight 200 lbs./ft. Dia. 5 in. to 80 ft. depth Wall Thickness: inches or Dia. <input type="checkbox"/> in. to <input type="checkbox"/> ft. depth gage No. 200	
			10. Screen: Manufacturer's name Sanflange Plastics Type RMP Dia. 5 in. Slot/gauze <input checked="" type="checkbox"/> Length 20 ft. Set between 160 ft. and 180 ft. Gravel pack? <input checked="" type="checkbox"/> Size range of material 4x1/2	
<table border="1"><thead><tr><th></th><th>From</th><th>To</th></tr></thead><tbody><tr><td>Top Soil</td><td>0</td><td>1</td></tr><tr><td>LT Tan Silt</td><td>1</td><td>6</td></tr><tr><td>DK. BR. Clay</td><td>6</td><td>14</td></tr><tr><td>" " " with Gyp</td><td>14</td><td>17</td></tr><tr><td>LT. BR. Clay</td><td>17</td><td>104</td></tr><tr><td>Sand Stone</td><td>104</td><td>105</td></tr><tr><td>Gravel 0" to 1/4"</td><td>105</td><td>108</td></tr><tr><td>Cream Colored Clay with Sandstone</td><td>108</td><td>118</td></tr><tr><td>Gravel - Rather Tight - Partly Cemented</td><td>118</td><td>132</td></tr><tr><td>Gravel - Not Cemented</td><td>132</td><td>146</td></tr><tr><td>Clay - Cream Colored</td><td>146</td><td>149</td></tr><tr><td>Gravel - with Clay Streaks - 6" to 12"</td><td>149</td><td>176</td></tr><tr><td>Thick EVERY 4 to 5 FT</td><td></td><td></td></tr><tr><td>LT BROWN SOFT SILT</td><td>176</td><td>200</td></tr>176	200	11. Static water level: 142 ft. below land surface Date 12-21-77 mo./day/yr.			
12. Pumping level below land surfaces: 142 ft. after 0 hrs. pumping <input type="checkbox"/> g.p.m. ft. after <input type="checkbox"/> hrs. pumping <input type="checkbox"/> g.p.m. Estimated maximum yield 15 g.p.m.	
13. Water sample submitted: <input checked="" type="checkbox"/> Yes <input type="checkbox"/> No Date <input type="checkbox"/>	
14. Well head completion: <input type="checkbox"/> Pitless adapter 20 inches above grade	
15. Well grouted? yes With: <input checked="" type="checkbox"/> Neat cement <input type="checkbox"/> Bentonite <input type="checkbox"/> Concrete Depth: From 0 ft. to 10 ft.	
16. Nearest source of possible contamination: Cattle ft. pastures Type Cattle Well disinfected upon completion? <input type="checkbox"/> Yes <input checked="" type="checkbox"/> No	
17. Pump: <input checked="" type="checkbox"/> Not installed Manufacturer's name <input type="checkbox"/> HP <input type="checkbox"/> Volts <input type="checkbox"/> Length of drop pipe <input type="checkbox"/> ft. capacity <input type="checkbox"/> g.p.m. Type: <input type="checkbox"/> Submersible <input type="checkbox"/> Turbine <input type="checkbox"/> Jet <input type="checkbox"/> Reciprocating <input type="checkbox"/> Centrifugal <input type="checkbox"/> Other	
18. Elevation:			19. Remarks:	
Topography: <input type="checkbox"/> Hill <input type="checkbox"/> Slope <input type="checkbox"/> Upland <input type="checkbox"/> Valley			20. Water well contractor's certification: This well was drilled under my jurisdiction and this report is true to the best of my knowledge and belief. Carl Kaye Water Well Serv. 224 Business name License No. Address 6635 Maple Greenway, Topeka, KS Signed Carl Kaye Date 12-22-77 Authorized representative	