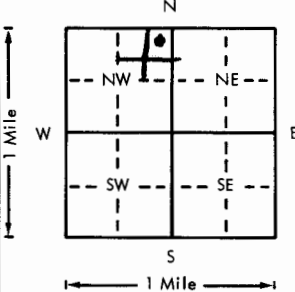
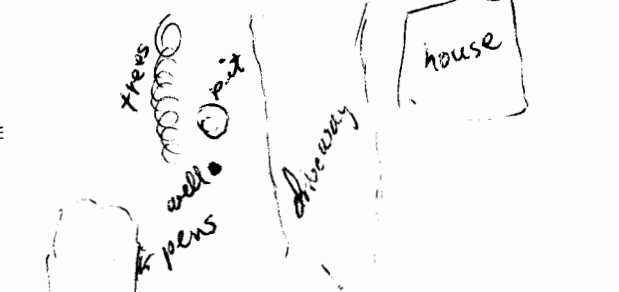


USE TYPEWRITER OR BALL
POINT PEN-PRESS FIRMLY,
PRINT CLEARLY.

WATER WELL RECORD
KSA 82a-1201-1215

Kansas Department of Health and
Environment-Division of Environment
(Water well Contractors)
Topeka, Kansas 66620

1. Location of well:		County FORD	Fraction NE 1/4 NE 1/4 NW 1/4	Section number 28	Township number T 29 S R 23	Range number 23
2. Distance and direction from nearest town or city: 2 mi N of Bloom 3 mi E of Bloom		3. Owner of well: George Brown R.R. or street: RFR City, state, zip code: Bloom Mo.				
4. Locate with "X" in section below:		Sketch map:				
						
5. Type and color of material		From	To	6. Bore hole dia. 2 3/4 in. Completion date 8-14-78 Well depth 240 ft.		
topsoil		0	5	7. <input checked="" type="checkbox"/> Cable tool <input checked="" type="checkbox"/> Rotary <input type="checkbox"/> Driven <input type="checkbox"/> Dug <input type="checkbox"/> Hollow rod <input type="checkbox"/> Jetted <input type="checkbox"/> Bored <input type="checkbox"/> Reverse rotary		
clay		6	150	8. Use: <input checked="" type="checkbox"/> Domestic <input type="checkbox"/> Public supply <input type="checkbox"/> Industry <input type="checkbox"/> Irrigation <input type="checkbox"/> Air conditioning <input type="checkbox"/> Stock <input type="checkbox"/> Lawn <input type="checkbox"/> Oil field water <input type="checkbox"/> Other		
clay and sand		151	166	9. Casing: Material <input type="checkbox"/> <input checked="" type="checkbox"/> PVC <input type="checkbox"/> RMP <input type="checkbox"/> Weight 200 lbs./ft. Dia. 5 in. to 240 ft. depth Wall Thickness: inches or Dia. <input type="checkbox"/> in. to <input type="checkbox"/> ft. depth gage No. 90 sch		
clay		167	180	10. Screen: Manufacturer's name JetStream Type PVC Dia. 5 Slot/gauze 1/4" Length 40 Set between 200 ft. and 240 ft. Gravel pack? Yes Size range of material 1/2 - 3/4"		
fine sand		181	200	11. Static water level: <input type="checkbox"/> mo./day/yr. 180 ft. below land surface Date 8/11/78		
clay		201	210	12. Pumping level below land surfaces: ____ ft. after 1 1/2 hrs. pumping 30 g.p.m. ____ ft. after ____ hrs. pumping ____ g.p.m. Estimated maximum yield 35 g.p.m.		
gravel		211	235	13. Water sample submitted: ____ mo./day/yr. <input type="checkbox"/> Yes <input checked="" type="checkbox"/> No Date ____		
clay		236	240	14. Well head completion: <input checked="" type="checkbox"/> Pitless adapter 12 inches above grade		
				15. Well grouted? Yes With: ____ Neat cement ____ Bentonite <input checked="" type="checkbox"/> Concrete Depth: From 5 ft. to 15 ft.		
				16. Nearest source of possible contamination: ft. 100 Direction SW Type Cattle pens Well disinfected upon completion? <input checked="" type="checkbox"/> Yes ____ No		
				17. Pump: ____ Not installed Manufacturer's name Aermator Model number ____ HP 2 hp Volts 230 Length of drop pipe 236 ft. capacity 20 g.p.m. Type: <input checked="" type="checkbox"/> Submersible <input type="checkbox"/> Turbine <input type="checkbox"/> Jet <input type="checkbox"/> Reciprocating <input type="checkbox"/> Centrifugal <input type="checkbox"/> Other		
18. Elevation:		(Use a second sheet if needed)		20. Water well contractor's certification: This well was drilled under my jurisdiction and this report is true to the best of my knowledge and belief. Bartel Dry 101A Business name 101A License No. Address 101A Signed Michael R. Bartel Date 9-26-78 Authorized representative		
19. Remarks:						
Topography: <input type="checkbox"/> Hill <input type="checkbox"/> Slope <input checked="" type="checkbox"/> Upland <input type="checkbox"/> Valley						