


WATER WELL RECORD Form WWC-5 KSA 82a-1212

1 LOCATION OF WATER WELL: COUNTY: FORD Fraction NE 1/4 NE 1/4 SE 1/4 Section Number 26 Township Number T 29 S Range Number R 23 W

Distance and direction from nearest town or city street address of well if located within city? 2 MILES WEST, 1 3/4 MILES SOUTH OF KINGSDOWN

2 WATER WELL OWNER: WHITE, HAL RR#, St. Address, Box #: 12865 123 ROAD City, State, ZIP code: KINGSDOWN, KS 67842- Board of Agriculture, Division of Water Resources Application Number:

3 LOCATE WELL'S LOCATION WITH AN "X" IN SECTION BOX:

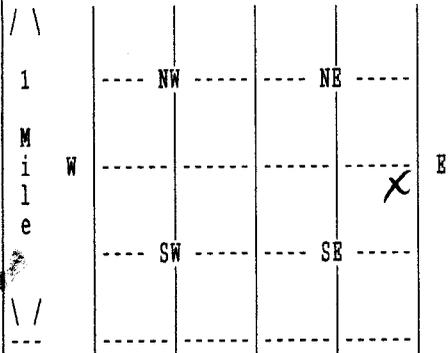

4 DEPTH OF COMPLETED WELL 250 ELEVATION: 0 Depth(s) Groundwater Encountered 1. 0 ft. 2. 0 ft. 3. 0 ft.

WELL'S STATIC WATER LEVEL 167 ft. below land surface measured on mo/day/yr 09/27/04 Pump test data: Well water was 0 ft. after 0 hours pumping 0 gpm

Estimated Yield 0 gpm: Well water was 0 ft. after 0 hours pumping 0 gpm

Bore Hole Diameter 8.75 in. to 250 ft., and in. to 0 ft.

WELL WATER TO BE USED AS: DOMESTIC

Was a chemical/bacteriological sample submitted to department? No; If yes, mo/day/yr sample was submitted Water well disinfected? Yes

5 TYPE OF BLANK CASING USED: PVC CASING JOINTS: GLUED Blank casing diameter 5 in. to 230 ft., Dia in. to 0 ft., Dia in. to 0 ft. Casing height above land surface 12 in., weight 0 lbs/ft. Wall thickness or gauge No. 21 TYPE OF SCREEN OR PERFORATION MATERIAL: PVC SCREEN OR PERFORATION OPENINGS ARE: SAW CUT

SCREEN PERFORATED INTERVALS: From 230 ft. to 250 ft., From 0 ft. to 0 ft. From 0 ft. to 0 ft., From 0 ft. to 0 ft. GRAVEL PACK INTERVALS: From 25 ft. to 250 ft., From 0 ft. to 0 ft. From 0 ft. to 0 ft., From 0 ft. to 0 ft.

6 GROUT MATERIAL BENTONITE Grout Intervals: From 4 ft. to 25 ft., From 0 ft. to 0 ft., From 0 ft. to 0 ft. What is the nearest source of possible contamination: SEPTIC TANK Direction from well? SOUTHEAST How many feet? 120

Table with columns: FROM, TO, LITHOLOGIC LOG, FROM, TO, PLUGGING INTERVALS. Rows describe geological layers from 0 to 225 feet depth, including BROWN CLAY, TAN CLAY, SAND AND GRAVEL.

7 CONTRACTOR'S OR LANDOWNER'S CERTIFICATION: This water well was Constructed under my jurisdiction and was completed on (mo/day/year) 09/27/04 and this record is true to the best of my knowledge and belief. Kansas Water Well Contractor's License No. 653 This Water Well Record was completed on (mo/day/yr) 12/08/04 under the business name of DAN HAYSE WATER WELL SERV by (signature) Dan Hayse