


1 LOCATION OF WATER WELL:		Fraction	Section Number	Township Number	Range Number
County:	FORD	SE ¼ SE ¼ NW ¼	9	T 29 S	R 24 E/W

Distance and direction from nearest town or city street address of well if located within city?

3 East, ~~8~~ 5½ North of Minneola, Kansas

2 WATER WELL OWNER:	Wm. H. Buchanan Estate, c/o W. Maxine Brown, Trustee	
RR#, St. Address, Box # :	511 Ave. F <i>Buckhannan</i>	Board of Agriculture, Division of Water Resources
City, State, ZIP Code :	Dodge City, Kansas 67801	Application Number: ---

LOCATE WELL'S LOCATION WITH AN "X" IN SECTION BOX: 4 DEPTH OF COMPLETED WELL: 187 ft. ELEVATION: Upland

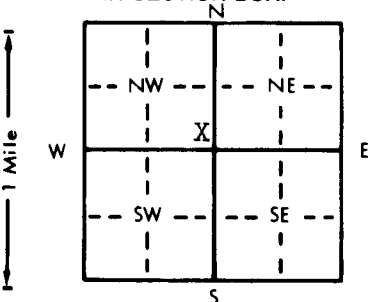

4 DEPTH OF COMPLETED WELL..... 187..... ft. ELEVATION: Upland.....
 Depth(s) Groundwater Encountered 1.... Not available..... ft. 3..... ft.
 WELL'S STATIC WATER LEVEL... 119... ft. below land surface measured on mo/day/yr July 29, 1983...
 Pump test data: Well water was ft. after hours pumping gpm
 Est. Yield .. 5-10. gpm: Well water was ft. after hours pumping gpm
 Bore Hole Diameter .. 9.7/8. in. to 187..... ft., and in. to ft.
 WELL WATER TO BE USED AS: 5 Public water supply 8 Air conditioning 11 Injection well
 ① Domestic 3 Feedlot 6 Oil field water supply 9 Dewatering XX2 Other (Specify below)
 2 Irrigation 4 Industrial 7 Lawn and garden only 10 Observation well Stock.....
 Was a chemical/bacteriological sample submitted to Department? Yes..... No... XX.....; If yes, mo/day/yr sample was submitted
 Water Well Disinfected? Yes XX No

5	TYPE OF BLANK CASING USED:	5 Wrought iron	8 Concrete tile	CASING JOINTS: Glued . XX . Clamped
	1 Steel	3 RMP (SR)	6 Asbestos-Cement	9 Other (specify below)
	XX PVC	4 ABS	7 Fiberglass	Welded
				Threaded.

Blank casing diameter . . . 5 . . . in. to . . . 137 . . . ft., Dia . . . in. to . . . ft., Dia . . . in. to . . . ft.
Casing height above land surface . . . 24 . . . in., weight . . . 2.8 . . . lbs./ft. Wall thickness or gauge No. . . . 265

TYPE OF SCREEN OR PERFORATION MATERIAL:			XX PVC	10 Asbestos-cement
1 Steel	3 Stainless steel	5 Fiberglass	8 RMP (SR)	11 Other (specify)
2 Brass	4 Galvanized steel	6 Concrete tile	9 ABS	12 None used (open hole)

SCREEN OR PERFORATION OPENINGS ARE:

1 Continuous slot	3 Mill slot	5 Gauzed wrapped	XX 8 Saw cut	11 None (open hole)
2 Louvered shutter	4 Key punched	6 Wire wrapped	9 Drilled holes	
		7 Torch cut	10 Other (specify)	

SCREEN-PERFORATED INTERVALS: From 137 ft. to 157 ft., From ft. to ft.
From ft. to ft., From ft. to ft.
GRAVEL PACK INTERVALS: From 10 ft. to 157 ft., From ft. to ft.
From ft. to ft. From ft. to ft.

5 GROUT MATERIAL: ☒ Neat cement 2 Cement grout 3 Bentonite 4 Other _____

Grout Intervals: From 0 ft. to 10 ft. From _____ ft. to _____ ft. From _____ ft. to _____ ft.

What is the nearest source of possible contamination:			10 Livestock pens	XX4 Abandoned water well
1 Septic tank	4 Lateral lines	7 Pit privy	11 Fuel storage	15 Oil well/Gas well
2 Sewer lines	5 Cess pool	8 Sewage lagoon	12 Fertilizer storage	16 Other (specify below)
3 Watertight sewer lines	6 Seepage pit	9 Feedyard	13 Insecticide storage

Direction from well? Northwest How many feet? 20

[illegible]

7 CONTRACTOR'S OR LANDOWNER'S CERTIFICATION: This water well was (1) constructed, (2) reconstructed, or (3) plugged under my jurisdiction and was completed on (mo/day/year) August 1, 1983 and this record is true to the best of my knowledge and belief. Kansas

Water Well Contractor's License No. 252 This Water Well Record was completed on (mo/day/yr) August 8, 1983
under the business name of Friesen Windmill & Supply Inc. by (signature) [Signature]

INSTRUCTIONS: Use typewriter or ball point pen, PLEASE PRESS FIRMLY and PRINT clearly. Please fill in blanks underline or circle the correct answers. Send top three copies to Kansas Department of Health and Environment, Division of Environment, Environmental Geology Section, Topeka, KS 66620. Send one to WATER WELL OWNER and retain one for your records.