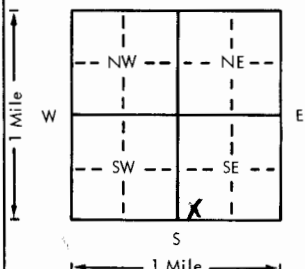


USE TYPEWRITER OR BALL
POINT PEN-PRESS FIRMLY,
PRINT CLEARLY.

WATER WELL RECORD
KSA 82a-1201-1215

Kansas Department of Health and
Environment-Division of Environment
(Water well Contractors)
Topeka, Kansas 66620

1. Location of well:		County Ford	Fraction SW 1/4 SW 1/4 SE 1/4	Section number 25	Township number T 29	Range number S R 24	EW
2. Distance and direction from nearest town or city: Street address of well location if in city:				3. Owner of well: Katherine Kleckner R.R. or street: City, state, zip code: Bloom, Ks 67833			
4. Locate with "X" in section below:		Sketch map:		6. Bore hole dia. 8 in. Completion date 5-23-79 Well depth 200 ft.			
				7. <input checked="" type="checkbox"/> Cable tool <input checked="" type="checkbox"/> Rotary <input type="checkbox"/> Driven <input type="checkbox"/> Dug <input type="checkbox"/> Hollow rod <input type="checkbox"/> Jetted <input type="checkbox"/> Bored <input type="checkbox"/> Reverse rotary			
5. Type and color of material		From		To		8. Use: <input checked="" type="checkbox"/> Domestic <input type="checkbox"/> Public supply <input type="checkbox"/> Industry <input type="checkbox"/> Irrigation <input type="checkbox"/> Air conditioning <input type="checkbox"/> Stock <input type="checkbox"/> Lawn <input type="checkbox"/> Oil field water <input type="checkbox"/> Other	
Topsoil		0		3		9. Casing: Material Plastic Weight 18 lbs./ft. Threading Welded Surface 18 in. RMP PVC Glue Weight 250 lbs./ft. Dia. 5 in. to 180 ft. depth Wall Thickness: inches or Dia. 5 in. to 180 ft. depth Gage No. 250	
Clay		3		152		10. Screen: Manufacturer's name Jess & Lowell Type Plastic Dia. 5" Slot/gauze 1/4" Length 20 Set between 180 ft. and 200 ft. Gravel pack? yes Size range of material 1/4"	
Gravel		152		161		11. Static water level: NA mo./day/yr. 120 ft. below land surface Date 5-23-79	
Clay		161		180		12. Pumping level below land surfaces: NA ____ ft. after ____ hrs. pumping ____ g.p.m. ____ ft. after ____ hrs. pumping ____ g.p.m. Estimated maximum yield ____ g.p.m.	
Gravel		180		200		13. Water sample submitted: ____ mo./day/yr. ____ Yes <input checked="" type="checkbox"/> No Date ____	
						14. Well head completion: <input checked="" type="checkbox"/> Pitless adapter 12 Inches above grade	
						15. Well grouted? yes With: <input checked="" type="checkbox"/> Neat cement <input type="checkbox"/> Bentonite <input type="checkbox"/> Concrete Depth: From 0 ft. to 15 ft.	
						16. Nearest source of possible contamination: ft. 100 Direction SW Type septic Well disinfected upon completion? <input checked="" type="checkbox"/> Yes ____ No	
						17. Pump: Manufacturer's name Dempster Model number HF3150S2 HP 1-12 Volts 220 Length of drop pipe 189' ft. capacity ____ g.p.m. Type: <input checked="" type="checkbox"/> Submersible <input type="checkbox"/> Turbine <input type="checkbox"/> Jet <input type="checkbox"/> Reciprocating <input type="checkbox"/> Centrifugal <input type="checkbox"/> Other	
						20. Water well contractor's certification: This well was drilled under my jurisdiction and this report is true to the best of my knowledge and belief. Cragg Well Drilling 111 Business name License No. Address Dodge City Ks. Signed Ray P. Cragg Date 5-23-79 Authorized representative	
18. Elevation: Level Topography: <input checked="" type="checkbox"/> Hill <input checked="" type="checkbox"/> Slope <input checked="" type="checkbox"/> Upland <input type="checkbox"/> Valley		19. Remarks:					