

Reply to: (785) 296-3565 FAX (785) 296-5509
 Bureau of Water - Geology Section
 1000 S. W. Jackson, Ste. 420
 Topeka, KS 66612-1367



ASSIGNMENT OF WATER WELL TO LANDOWNER

I, Myrland Hertlein of P.O. Box 1827
 (Landowner's address)

Ardmore Oklahoma am the landowner on which a water well is located in
 (City) (State)
 the SE quarter of the NW quarter of the SE quarter in Section 12, Township 29,
 Range 24 ~~E~~/W, in Ford County, Kansas which is approximately
1830 feet north/~~south~~, and 1470 feet ~~east~~/west of the apparent SE section
 corner. The water well was drilled in August 2011 (month/year).

I hereby request that Vincent Oil Corporation leave the water well,
 (Operator name)

which was drilled by Temporary Water Permit # 20110369 00, unplugged, and I will
 assume all responsibility for the plugging of said water well in accordance with the requirements
 of the Kansas Department of Health and Environment regulation K.A.R. 28-30-7.

LANDOWNER:

Myrland Hertlein, TEE. 2/7/12
 (Signature) (Date)

Myrland Hertlein
 (Print)

OPERATOR:

M. L. Korphage 1/28/2012
 (Signature) (Date)

By: M.L. Korphage P.G.
 (Agent) Vincent Oil Corporation

IF ADDITIONAL LANDOWNER

 (Signature) (Date)

 (Print)

Check: ☐ White Copy, ☐ Blue Copy, ☐ Pink Copy

WATER RESOURCES
RECEIVED

Submit To:

CHIEF ENGINEER
Division of Water Resources
Kansas Department of Agriculture
109 SW 9th Street, 2nd Floor
Topeka, KS 66612-1283
www.ksda.gov/dwr

APPLICATION FOR
TEMPORARY PERMIT

☒ GROUNDWATER KS DEPT OF AGRICULTURE
☐ SURFACE WATER
(check one)

AUG 18 2011

12:51 PM



State of Kansas

STATUTORY FILING FEE OF \$200.00 MUST ACCOMPANY THIS APPLICATION

(Make check payable to the Kansas Department of Agriculture)

FO 2
GMD 3
MEETS 9
K.A.R. 5-1
BY KAR
DATE 8/18/2011

1. Applicant: (Please print or type)

Name Vincent Oil
Street 90 Rosencrantz - Bemis
P.O. Box 713
City and State Great Bend, KS
Zip Code 67530 Te
Social Security I.D. No.
and/or Taxpayer I.D. No.

6. Period of use (6 months maximum):

Commencing date: Aug. 23 2011
Ending Date: Dec. 22 2011

2. Location of Point of Diversion:

Sec. 13, Twp. 29, Rng. 24, (E/W),
Ford County, Kansas.

Distance from Southeast Corner of Section:

1830 feet North from Southeast Corner
1470 feet West from Southeast Corner

Existing water right? Yes ☐ No ☒
If yes, File No. _____

Pending application? Yes ☐ No ☒
If yes, File No. _____

3. Water Use Data:

Proposed Max. Pumping Rate (gpm) 40 GPM
Amount Requested (gallons) 1/2 million
(not to exceed one million gallons unless for dewatering)
Depth of Well (feet) 220 - 240 ft. OR
Name of Stream _____


4. Water is to be used for (briefly describe proposed use):

drilling oil well

5. Location of place of use:

NE/SE/NW/SE
12-29-24
Ford County

The scale of the diagram is 2 inches = 1 mile
Each small square represents 10 acres

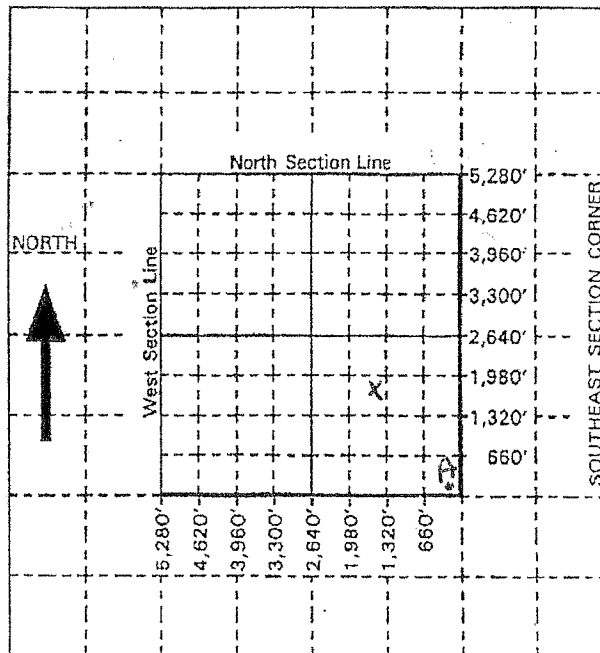

For Office Use Only: Code TMP Fee \$200 TR # _____ Receipt Date 8-18-11 Check # _____