


1 LOCATION OF WATER WELL: Fraction SW 1/4 SW 1/4 SE Section Number 25 Township Number T. 29 S. Range Number R. 24 E.  
 COUNTY: FORD

Distance and direction from nearest town or city street address of well if located within city?

208 BLOOM ST. BLOOM, KS 67833-

2 WATER WELL OWNER: HELLSTORM, AL Board of Agriculture, Division of Water Resources  
 RR#, St. Address, Box #: 208 BLOOM ST. Application Number:  
 City, State, ZIP code: BLOOM, KS 67833-

3 LOCATE WELL'S LOCATION WITH AN "X" IN SECTION BOX:

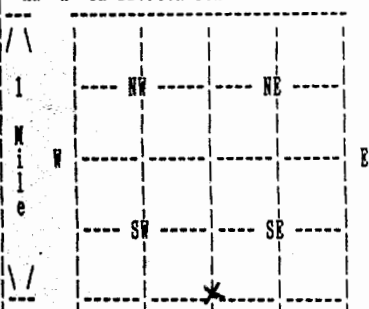

4 DEPTH OF COMPLETED WELL 0 ELEVATION: 0  
 Depth(s) Groundwater Encountered 1. 0 ft. 2. 0 ft. 3. 0 ft.

WELL'S STATIC WATER LEVEL 0 ft. below land surface measured on no/day/yr  
 Pump test data: Well water was 0 ft. after 0 hours pumping 0 gpm

Estimated Yield 0 gpm: Well water was 0 ft. after 0 hours pumping 0 gpm

Bore Hole Diameter in. to 0 ft., and in. to 0 ft.

WELL WATER WAS: DOMESTIC

Was a chemical/bacteriological sample submitted to department? No ;  
 If yes, no/day/yr sample was submitted Water well disinfected? Yes

5 TYPE OF BLANK CASING USED:

Blank casing diameter 5 in. to 180 ft., Dia in. to 0 ft., Dia in. to 0 ft.  
 Casing height above land surface 0 in., weight 0 lbs/ft. Wall thickness or gauge No.

TYPE OF SCREEN OR PERFORATION MATERIAL:

SCREEN OR PERFORATION OPENINGS ARE:

SCREEN PERFORATED INTERVALS:	FROM	TO	FROM	TO	FROM	TO	
	0 ft.	to	0 ft.	FROM	0 ft.	to	0 ft.
	0 ft.	to	0 ft.	FROM	0 ft.	to	0 ft.
GRAVEL PACK INTERVALS:	0 ft.	to	0 ft.	FROM	0 ft.	to	0 ft.
	0 ft.	to	0 ft.	FROM	0 ft.	to	0 ft.

6 GROUT MATERIAL BENTONITE

Grout intervals: From 0 ft. to 0 ft., From 0 ft. to 0 ft., From 0 ft. to 0 ft.

What is the nearest source of possible contamination: NONE

Direction from well?

How many feet? 0

FROM	TO	LITHOLOGIC LOG	FROM	TO	PLUGGING INTERVALS
			0	2	CEMENT
			2	12	BENTONITE GROUT
			12	130	FILL SAND
			130	140	BENTONITE GROUT
			140	180	FILL SAND
			0	0	
			0	0	
			0	0	
			0	0	
			0	0	

7 CONTRACTOR'S OR LANDOWNER'S CERTIFICATION: This water well was Plugged under my jurisdiction and was completed on (no/day/year) 11/04/94 and this record is true to the best of my knowledge and belief. Kansas  
 Water Well Contractor's License No. 179 This Water Well Record was completed on (no/day/yr) 11/21/94  
 under the business name of JOB'S WELL SERVICE, INC. by (signature) Judith Creek