WATER WELL RECORD Form WWC-5 KSA 82a-1212

1 LOCATION OF WATER WELL: County: Ford | Fraction: NE ¼ NE ¼ SW ¼ | Section Number: 6 | Township Number: T 29 S | Range Number: R 24 E/W

Distance and direction from nearest town or city street address of well if located within city?
From SE Corner of Dodge City-13 Miles South on Hwy. 283, 2 Miles East, 2,123 Ft. N. & 2,763 Ft. W.

2 WATER WELL OWNER: Don Irons
RR#, St. Address, Box # : 11252 Wildfire Road
City, State, ZIP Code : Minneola, Kansas 67865
Board of Agriculture, Division of Water Resources
Application Number: 12,563 & 25,251

3 LOCATE WELL'S LOCATION WITH AN "X" IN SECTION BOX:

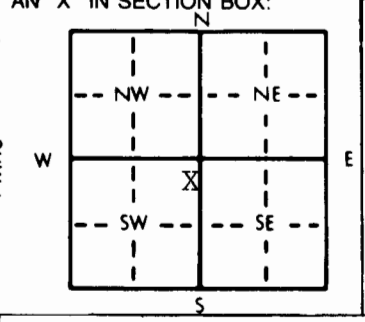

4 DEPTH OF COMPLETED WELL 290 ft. ELEVATION:
Depth(s) Groundwater Encountered 1. ft. 2. ft. 3. ft.
WELL'S STATIC WATER LEVEL 139 ft. below land surface measured on mo/day/yr 3-18-95
Pump test data: Well water was ft. after hours pumping gpm
Est. Yield gpm: Well water was ft. after hours pumping gpm
Bore Hole Diameter 30 in. to 290 ft., and in. to ft.
WELL WATER TO BE USED AS: 1 Domestic 2 Irrigation 3 Feedlot 4 Industrial 5 Public water supply 6 Oil field water supply 7 Lawn and garden only 8 Air conditioning 9 Dewatering 10 Monitoring well 11 Injection well 12 Other (Specify below)
Was a chemical/bacteriological sample submitted to Department? Yes No X; If yes, mo/day/yr sample was submitted
Water Well Disinfected? Yes No X

5 TYPE OF BLANK CASING USED: 1 Steel 2 PVC 3 RMP (SR) 4 ABS 5 Wrought iron 6 Asbestos-Cement 7 Fiberglass 8 Concrete tile 9 Other (specify below)
CASING JOINTS: Glued Clamped Welded X Threaded
Blank casing diameter 16 in. to 280 ft., Dia 20 in. to from 280 ft., Dia in. to ft.
Casing height above land surface 12 in., weight 16" - 42.05 20" - 52.73 lbs./ft. Wall thickness or gauge No. 250
TYPE OF SCREEN OR PERFORATION MATERIAL: 1 Steel 2 Brass 3 Stainless steel 4 Galvanized steel 5 Fiberglass 6 Concrete tile 7 PVC 8 RMP (SR) 9 ABS 10 Asbestos-cement 11 Other (specify) 12 None used (open hole)
SCREEN OR PERFORATION OPENINGS ARE: 1 Continuous slot 2 Louvered shutter 3 Mill slot 4 Key punched 5 Gauzed wrapped 6 Wire wrapped 7 Torch cut 8 Saw cut 9 Drilled holes 10 Other (specify) 11 None (open hole)
SCREEN-PERFORATED INTERVALS: 20" From 160 ft. to 280 ft., From ft. to ft.
16" From 280 ft. to 290 ft., From ft. to ft.
GRAVEL PACK INTERVALS: From 20 ft. to 95 ft., From 155 ft. to 290 ft.
From ft. to ft., From ft. to ft.

6 GROUT MATERIAL: 1 Neat cement 2 Cement grout 3 Bentonite 4 Other
Grout Intervals: From 0 ft. to 20 ft., From 95 ft. to 155 ft., From ft. to ft.
What is the nearest source of possible contamination:
1 Septic tank 2 Sewer lines 3 Watertight sewer lines 4 Lateral lines 5 Cess pool 6 Seepage pit 7 Pit privy 8 Sewage lagoon 9 Feedyard 10 Livestock pens 11 Fuel storage 12 Fertilizer storage 13 Insecticide storage 14 Abandoned water well 15 Oil well/Gas well 16 Other (specify below)
Direction from well? How many feet?

FROM	TO	LITHOLOGIC LOG	FROM	TO	PLUGGING INTERVALS
		See attached log			

7 CONTRACTOR'S OR LANDOWNER'S CERTIFICATION: This water well was (1) constructed, (2) reconstructed, or (3) plugged under my jurisdiction and was completed on (mo/day/year) 5-7-95 and this record is true to the best of my knowledge and belief. Kansas Water Well Contractor's License No. 208 This Water Well Record was completed on (mo/day/yr) 6-1-95
under the business name of Minter-Wilson Drilling Co., Inc. by (signature) Nora Keller

INSTRUCTIONS: Use typewriter or ball point pen. *PLEASE PRESS FIRMLY* and *PRINT* clearly. Please fill in blanks, underline or circle the correct answers. Send top three copies to Kansas Department of Health and Environment, Bureau of Water, Topeka, Kansas 66620-0001. Telephone: 913-296-5545. Send one to WATER WELL OWNER and retain one for your records.

OFFICE USE ONLY T R E/W SEC. ¼ ¼ ¼

The Professionals

MINTER-WILSON DRILLING CO.
INCORPORATED

Irrigation and Domestic Water Systems
Complete Installation and Repairing

Phone 276-8269 • P.O. Box A • GARDEN CITY, KANSAS 67846

Don Irons
Ford County
2/14/95

Location: SW¼ 6-29-24
From existing well - 108 Ft. N. &
106 Ft. West

Static Water Level - 140'

Test #2

0'	to	2'	- Top soil
2'	to	30'	Brown clay
30'	to	57'	Brown sandy clay
57'	to	83'	Brown clay brown rock mixed
83'	to	96'	Brown sandy clay cemented sand mixed - pull down
96'	to	107'	Brown clay white rock mixed
107'	to	111'	Fine to medium sand
111'	to	134'	Brown clay
134'	to	141'	Fine to medium sand
141'	to	149'	Brown sandy clay
149'	to	157'	- Fine to medium sand
157'	to	180'	Fine to medium sand - loose
180'	to	186'	Gray clay white rock mixed - tight
186'	to	194'	Sand stone - small clay streak
194'	to	203'	Brown sandy clay - small sand stone strip
203'	to	278'	Sand stone - 15% clay - pull down
278'	to	284'	Yellow clay
284'	to	290'	Shale

225' - Lost circulation