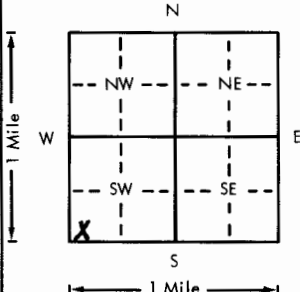


USE TYPEWRITER OR BALL
POINT PEN-PRESS FIRMLY,
PRINT CLEARLY.

WATER WELL RECORD
KSA 82a-1201-1215

Kansas Department of Health and
Environment-Division of Environment
(Water well Contractors)
Topeka, Kansas 66620

1. Location of well:		County Ford	Fraction SW 1/4 SW 1/4 SW 1/4	Section number 4	Township number T 29 S R 25 X/W	Range number
2. Distance and direction from nearest town or city: Dodge City on highway 283 and 3 miles west Street address of well location if in city:			3. Owner of well: Gus Bartlett R.R. or street: 1409 Ave. 1 City, state, zip code: Dodge City, Kansas 67801			
4. Locate with "X" in section below:		Sketch map:		6. Bore hole dia. 8 in. Completion date 12-9-76 Well depth 195 ft.		
				7. <input checked="" type="checkbox"/> Cable tool <input checked="" type="checkbox"/> Rotary <input type="checkbox"/> Driven <input type="checkbox"/> Dug <input type="checkbox"/> Hollow rod <input type="checkbox"/> Jetted <input type="checkbox"/> Bored <input type="checkbox"/> Reverse rotary		
5. Type and color of material		From	To	8. Use: <input checked="" type="checkbox"/> Domestic <input type="checkbox"/> Public supply <input type="checkbox"/> Industry <input type="checkbox"/> Irrigation <input type="checkbox"/> Air conditioning <input type="checkbox"/> Stock <input type="checkbox"/> Lawn <input type="checkbox"/> Oil field water <input type="checkbox"/> Other		
Top soil & clay		0	15	9. Casing: Material RMP Height: Above ground Threaded <input type="checkbox"/> Welded <input type="checkbox"/> Surface 12 in. RMP <input checked="" type="checkbox"/> PVC <input type="checkbox"/> Weight <input type="checkbox"/> lbs./ft. Dia. 5 in. to 195 ft. depth Wall Thickness: inches or Dia. <input type="checkbox"/> in. to <input type="checkbox"/> ft. depth gage No. 250		
Clay		15	45	10. Screen: Manufacturer's name Sunflower Type RMP Dia. 5" Slot/ 1/8" Length 20 ft. Set between 170 ft. and 190 ft. ft. and <input type="checkbox"/> ft. Gravel pack? yes Size range of material 1"		
Clay & cleachie		45	75	11. Static water level: <input type="checkbox"/> mo./day/yr. 123 ft. below land surface Date 12-9-76		
Cleachie & fine sand		75	90	12. Pumping level below land surfaces: 127 ft. after 1 hrs. pumping 20 g.p.m. <input type="checkbox"/> ft. after <input type="checkbox"/> hrs. pumping <input type="checkbox"/> g.p.m. Estimated maximum yield 35 g.p.m.		
Fine sand & clay		90	120	13. Water sample submitted: <input type="checkbox"/> Yes <input checked="" type="checkbox"/> No Date <input type="checkbox"/>		
Fine sand		120	150	14. Well head completion: <input checked="" type="checkbox"/> Pitless adapter 12 Inches above grade		
Fine to medium sand		150	165	15. Well grouted? yes With: <input checked="" type="checkbox"/> Neat cement <input type="checkbox"/> Bentonite <input type="checkbox"/> Concrete Depth: From 5 ft. to 15 ft.		
Medium sand & coarse sand		165	180	16. Nearest source of possible contamination: ft. 85 Direction NW Type Sewer Well disinfected upon completion? <input checked="" type="checkbox"/> Yes <input type="checkbox"/> No		
Coarse sand & clay		180	195	17. Pump: <input type="checkbox"/> Not installed Manufacturer's name Aermotor Model number SD5-50 HP 1/2 Volts 230 Length of drop pipe 168 ft. capacity 5 g.p.m. Type: <input checked="" type="checkbox"/> Submersible <input type="checkbox"/> Turbine <input type="checkbox"/> Jet <input type="checkbox"/> Reciprocating <input type="checkbox"/> Centrifugal <input type="checkbox"/> Other		
Clay		195	225	20. Water well contractor's certification: This well was drilled under my jurisdiction and this report is true to the best of my knowledge and belief. JOE'S WELL SERVICE 179 Business name License No. Address Box 174 Cimarron, Ks. Signed Larry J. Crick Date 1-21-77 Authorized representative		
18. Elevation:		19. Remarks:				
Topography: <input checked="" type="checkbox"/> Hill <input type="checkbox"/> Slope <input type="checkbox"/> Upland <input type="checkbox"/> Valley		has good drainage to the South & East				

29 25 W 4
Sec 1/4 1/4
SUSAN