

USE TYPEWRITER OR BALL POINT PEN-PRESS FIRMLY, PRINT CLEARLY.


T R EW sec 1/4 1/4 1/4 No.

WATER WELL RECORD
KSA 82a-1201-1215

Kansas State Dept. Of Health
(Water Well Contractors)
Forbes-Bldg. 740
Topeka, Kansas 66620

1 Location of well:	County FORD	Township name WILBORN	Fraction NW 1/4	Section number 9	Town number 29	Range number 25
---------------------	-----------------------	---------------------------------	---------------------------	----------------------------	--------------------------	---------------------------

Distance and direction from nearest town or city: 13 miles South	3 Owner of well: Don Feis
Street address of well location if in city: 2 1/2 west of South Side of Dodge City Kan	
Address: R.F.D. 1 menneka Kan.	

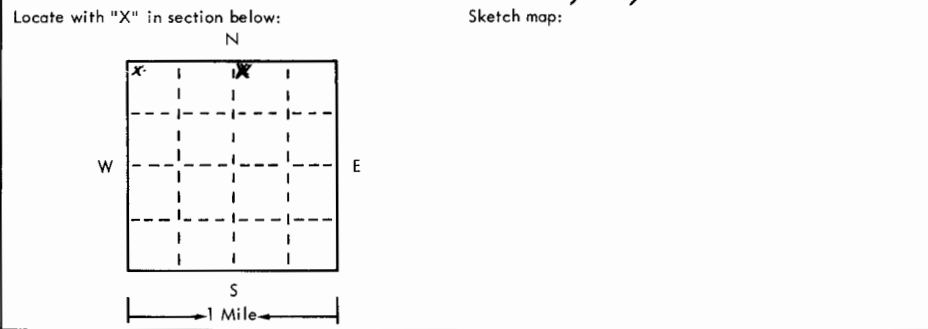

4 Well depth: 246 ft. Date of completion _____
Well diameter 28 in. Hole 14 in casing
5 <input type="checkbox"/> Cable tool <input type="checkbox"/> Rotary <input type="checkbox"/> Driven <input type="checkbox"/> Dug <input type="checkbox"/> Hollow rod <input type="checkbox"/> Jetted <input type="checkbox"/> Bored <input checked="" type="checkbox"/> Reverse rotary
6 Use: <input type="checkbox"/> Domestic <input type="checkbox"/> Public supply <input type="checkbox"/> Industry <input checked="" type="checkbox"/> Irrigation <input type="checkbox"/> Air conditioning <input type="checkbox"/> Commercial <input type="checkbox"/> Test well <input type="checkbox"/>
7 Casing: Material Steel Height: above/below _____ Threaded <input type="checkbox"/> Welded <input checked="" type="checkbox"/> Surface _____ in. Diam. _____ Weight _____ lbs./ft. _____ 4 in. to 246 ft. depth Drive shoe? <input type="checkbox"/> Yes <input type="checkbox"/> No _____ in. to _____ ft. depth

2	Type and color of material	From	To
	Surface soil	0	3
	Brown clay	3	75
	Brown caliche clay	75	105
	Green & Brown clay	105	140
	good sand & gravel	140	148
	clay	148	160
	sand & gravel	160	167
	caliche clay	167	187
	good loose sand & gravel	187	196
	Brown clay	196	205
	good sand & gravel	205	215
	clay	215	217
	good loose sand & gravel	217	245
	caliche clay	245	260
	(use a second sheet if needed)		

8 Screen: Manufacturer WARRIEN Type Baffle Dia. 16 in Slot/gauze 1/2 Length 110 ft Set between 136 ft. and 246 ft. _____ Fittings: Gravel pack <input checked="" type="checkbox"/> Yes <input type="checkbox"/> No Size range of material 1/2 down
9 Static water level: 142 ft. below land surface Date _____
10 Pumping level below land surfaces: 177 ft. after 1 hrs. pumping 1400 g.p.m. _____ ft. after _____ hrs. pumping _____ g.p.m. Estimated maximum yield 1400 g.p.m.
11 Water sample submitted: <input type="checkbox"/> Yes <input checked="" type="checkbox"/> No Date _____
12 Well head completion: <input type="checkbox"/> Pitless adapter <input type="checkbox"/> Inches above grade
13 Well grouted? <input checked="" type="checkbox"/> Yes <input type="checkbox"/> No <input type="checkbox"/> Neat cement <input type="checkbox"/> Bentonite <input type="checkbox"/> _____ Depth: From _____ ft. to _____ ft.
14 Nearest source of possible contamination: ft. from Direction _____ Type _____ Well disinfected upon completion? <input type="checkbox"/> Yes <input checked="" type="checkbox"/> No
15 Pump: <input type="checkbox"/> Not installed Manufacturer's name AVORA Model number 17AC8 HP 100 Volts _____ Length of drop pipe 220 ft. capacity 1400 g.m.p. Type: <input type="checkbox"/> Submersible <input checked="" type="checkbox"/> Turbine <input type="checkbox"/> Jet <input type="checkbox"/> Reciprocating <input type="checkbox"/> Centrifugal <input type="checkbox"/> Other

16 Remarks: elevation

Topography:
 Hill
 Slope
 Upland
 Valley

17 Water well contractor's certification:
This well was drilled under my jurisdiction and this report is true to the best of my knowledge and belief.

J. O. Johnson **183**
Business name License No.
Address **Dodge City Kan**
Signed **J. O. Johnson** Date _____
Authorized representative