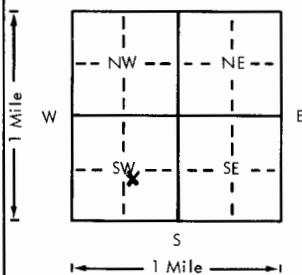


USE TYPEWRITER OR BALL
POINT PEN-PRESS FIRMLY,
PRINT CLEARLY.

WATER WELL RECORD
KSA 82a-1201-1215

Kansas Department of Health and
Environment-Division of Environment
(Water well Contractors)
Topeka, Kansas 66620

1. Location of well:	County Ford	Fraction NW 1/4 SE 1/4 SW 1/4	Section number 12	Township number T 29 S R 25 E/W	Range number 25
2. Distance and direction from nearest town or city: Smiles N minneola ks		3. Owner of well: William Kornelsen R.R. or street: Minneola, Ks 67865 City, state, zip code:			
4. Locate with "X" in section below: 		Sketch map: Pasture well			
5. Type and color of material		From	To	6. Bore hole dia. 8" in. Completion date 9-27-78 Well depth 225 ft.	
Topsoil		0	3	7. <input checked="" type="checkbox"/> Cable tool <input checked="" type="checkbox"/> Rotary <input type="checkbox"/> Driven <input type="checkbox"/> Dug <input type="checkbox"/> Hollow rod <input type="checkbox"/> Jetted <input type="checkbox"/> Bored <input type="checkbox"/> Reverse rotary	
Clay		3	160	8. Use: <input type="checkbox"/> Domestic <input type="checkbox"/> Public supply <input type="checkbox"/> Industry <input type="checkbox"/> Irrigation <input type="checkbox"/> Air conditioning <input checked="" type="checkbox"/> Stock <input type="checkbox"/> Lawn <input type="checkbox"/> Oil field water <input type="checkbox"/> Other	
Gravel		160	200	9. Casing: Material Plastic Height: Above or below 18 in. Threaded <input type="checkbox"/> Welded <input type="checkbox"/> Surface 18 in. RMP <input type="checkbox"/> PVC Blue Weight 150 lbs./ft. Dia. 5 in. to 205 ft. depth Wall Thickness: inches or Dia. 5 in. to 205 ft. depth gage No. 250	
Loose rock		200	215	10. Screen: Manufacturer's name Jess & Lowell Type Plastic Dia. 5" Slot/groove 1/4 Length 20 Set between 205 ft. and 225 ft. ft. and ft. Gravel pack? yes Size range of material 1/4	
Rock & clay		215	225	11. Static water level: N/A mo./day/yr. 161 ft. below land surface Date 9-27-78	
				12. Pumping level below land surfaces: N/A ft. after hrs. pumping g.p.m. ft. after hrs. pumping g.p.m. Estimated maximum yield g.p.m.	
				13. Water sample submitted: mo./day/yr. Yes <input checked="" type="checkbox"/> No <input type="checkbox"/> Date	
				14. Well head completion: <input checked="" type="checkbox"/> Pitless adapter 18" inches above grade	
				15. Well grouted? yes With: <input checked="" type="checkbox"/> Neat cement <input type="checkbox"/> Bentonite <input type="checkbox"/> Concrete Depth: From 0 ft. to 20 ft.	
				16. Nearest source of possible contamination: Pasture well ft. Direction Type Well disinfected upon completion? <input checked="" type="checkbox"/> Yes <input type="checkbox"/> No	
				17. Pump: <input checked="" type="checkbox"/> Not installed Manufacturer's name Model number HP Volts Length of drop pipe ft. capacity g.p.m. Type: <input type="checkbox"/> Submersible <input type="checkbox"/> Turbine <input type="checkbox"/> Jet <input type="checkbox"/> Reciprocating <input type="checkbox"/> Centrifugal <input type="checkbox"/> Other	
18. Elevation:		19. Remarks: Pasture well			
Topography: <input type="checkbox"/> Hill <input checked="" type="checkbox"/> Slope <input type="checkbox"/> Upland <input type="checkbox"/> Valley		20. Water well contractor's certification: This well was drilled under my jurisdiction and this report is true to the best of my knowledge and belief. Cragg Well Drilling 111 Business name License No. Address Dodge City, Ks 67801 Signed Larry Phyllis Date 9-27-78 Authorized representative			

29 25 E 12 NW SE SW
T R Sec 1/4 1/4 1/4