

1 LOCATION OF WATER WELL:		Fraction		Section Number		Township Number		Range Number	
County: Ford		$\frac{1}{4}$ $\frac{1}{4}$ NW $\frac{1}{4}$		25		T 29 S		R 25 E/W	

1 LOCATION OF WATER WELL:		Fraction		Section Number		Township Number		Range Number	
County: Ford		$\frac{1}{4}$ $\frac{1}{4}$ NW $\frac{1}{4}$		25		T 29 S		R 25 E/W	


Distance and direction from nearest town or city street address of well if located within city?

16 1/2 S of Dodge City, KS

2 WATER WELL OWNER: Howard McCune
RR#, St. Address, Box # : RFD
City, State, ZIP Code : Minneapolis, KS

Board of Agriculture, Division of Water Resources
Application Number: 82-559

9 LOCATE WELL'S LOCATION WITH AN "X" IN SECTION BOX: 4 DEPTH OF COMPLETED WELL... 200 ft. ELEVATION: 21

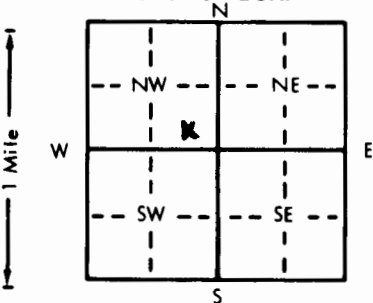

Depth(s) Groundwater Encountered 1. 75 ft. 2. _____ ft. 3. _____ ft.

WELL'S STATIC WATER LEVEL 125 ft. below land surface measured on mo/day/yr 11/1/82

Pump test data: Well water was 140 ft. after 2 hours pumping 40 gpm

Est. Yield 50 gpm: Well water was _____ ft. after _____ hours pumping _____ gpm

Bore Hole Diameter 9 in. to 200 ft., and _____ in. to _____ ft.

WELL WATER TO BE USED AS:

1 Domestic	3 Feedlot	6 <u>Oil field water supply</u>	9 Dewatering	12 Other (Specify below)
2 Irrigation	4 Industrial	7 <u>Lawn and garden only</u>	10 Observation well	

Was a chemical/bacteriological sample submitted to Department? Yes.....No.....X; If yes, mo/day/yr sample was submitted

Water Well Disinfected? Yes X No

5	TYPE OF BLANK CASING USED:	5 Wrought iron	8 Concrete tile	CASING JOINTS: Glued <input checked="" type="checkbox"/> Clamped
	1 Steel	3 RMP (SR)	6 Asbestos-Cement	9 Other (specify below)
	2 PVC	4 ABS	7 Fiberglass	Welded
				Threaded

Blank casing diameter 3 in. to 120 ft. Dia. in. to ft. Dia. in. to ft.
Casing height above land surface 14 in. weight 200 lbs./ft. Wall thickness or gauge No. 0.265

TYPE OF SCREEN OR PERFORATION MATERIAL:			<u>7 PVC</u>	10 Asbestos-cement
1 Steel	3 Stainless steel	5 Fiberglass	8 RMP (SR)	11 Other (specify)
2 Brass	4 Galvanized steel	6 Concrete tile	9 ABS	12 None used (open hole)

SCREEN OR PERFORATION OPENINGS ARE:

1 Continuous slot	3 Mill slot	5 Gauzed wrapped	<u>8 Saw cut</u>	11 None (open hole)
2 Louvered shutter	4 Key punched	6 Wire wrapped	9 Drilled holes	
		7 Torch cut	10 Other (specify)	

SCREEN-PERFORATED INTERVALS: From 125 ft. to 200 ft., From _____ ft. to _____ ft.
From _____ ft. to _____ ft., From _____ ft. to _____ ft.

GRAVEL PACK INTERVALS: From 115 ft. to 200 ft., From _____ ft. to _____ ft.
From _____ ft. to _____ ft., From _____ ft. to _____ ft.

9 GROUT MATERIAL:		1 Neat cement	2 Cement grout	3 Bentonite	4 Other
Grout Intervals:	From	ft. to	ft.	From	ft. to

What is the nearest source of possible contamination:

1 Septic tank	4 Lateral lines	7 Pit privy	10 Livestock pens	14 Abandoned water well
2 Sewer lines	5 Cess pool	8 Sewage lagoon	11 Fuel storage	15 Oil well/Gas well
3 Watertight sewer lines	6 Seepage pit	9 Feedyard	12 Fertilizer storage	16 Other (specify below)
			13 Insecticide storage	

Direction from well? _____ How many feet? _____

[illegible]

7. CONTRACTOR'S OR LANDOWNER'S CERTIFICATION: This water well was (1) constructed, (2) reconstructed, or (3) plugged under my jurisdiction and was completed on (mo/day/year) 11/4/82 and this record is true to the best of my knowledge and belief. Kansas

Water Well Contractor's License No. 142 This Water Well Record was completed on (mo/day/yr) 10/20/88
under the business name of T & W Water Well Service by (signature) CD Wagner
INSTRUCTIONS: Use typewriter or ball point pen, PLEASE PRESS FIRMLY and PRINT clearly. Please fill in blanks, underline or circle the correct answers. Send top three copies to Kansas Department of Health and Environment, Division of Environment, Environmental Geology Section, Topeka, KS 66620. Send one to WATER WELL OWNER and retain one for your records.