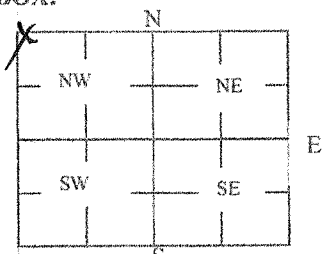


## WATER WELL PLUGGING RECORD Form WWC-5P

KSA 82a-1212 ID NO.

<b>1 LOCATION OF WATER WELL:</b> County: <u>FORD</u> Street/Rural Address of Well Location; if unknown, distance & direction from nearest town or intersection: If at owner's address, check here <input checked="" type="checkbox"/>	Fraction <u>NW 1/4 NW 1/4 NW 1/4 NW 1/4</u> Section Number <u>10</u> Township Number <u>T 29 S</u> Range Number <u>25</u> <input type="checkbox"/> E <input checked="" type="checkbox"/> W	<b>Global Positioning Systems (GPS) information:</b> Latitude: <u>37.54644°</u> (in decimal degrees) Longitude: <u>100.05160°</u> (in decimal degrees) Elevation: <u>2020</u> Datum: <input checked="" type="checkbox"/> WGS84, <input type="checkbox"/> NAD83, <input type="checkbox"/> NAD27 Collection Method: <input type="checkbox"/> GPS unit (Make/Model: _____) <input type="checkbox"/> Digital Map/Photo, <input type="checkbox"/> Topographic Map, <input type="checkbox"/> Land Survey Est. Accuracy: <input type="checkbox"/> < 3 m, <input type="checkbox"/> 3-5 m, <input type="checkbox"/> 5-15 m, <input type="checkbox"/> > 15 m	
<b>2 WATER WELL OWNER:</b> <u>George Harshberger</u> <u>Harshberger Farms, Inc.</u> RR#, St. Address, Box #: <u>10905 Wildfire Rd.</u> City, State ZIP Code: <u>Minnicola, KS 67865</u>		<b>3 MARK WELL'S LOCATION WITH AN "X" IN SECTION BOX:</b> <div style="text-align: center;">  </div>	
<b>4 DEPTH OF WELL</b> <u>240</u> ft. WELL'S STATIC WATER LEVEL <u>190</u> ft. WELL WAS USED AS: <input checked="" type="checkbox"/> Domestic <input type="checkbox"/> Public Water Supply <input type="checkbox"/> Dewatering <input type="checkbox"/> Irrigation <input type="checkbox"/> Oil Field Water Supply <input type="checkbox"/> Monitoring <input type="checkbox"/> Feedlot <input type="checkbox"/> Domestic (Lawn & Garden) <input type="checkbox"/> Injection Well <input type="checkbox"/> Industrial <input type="checkbox"/> Air Conditioning Was a chemical/bacteriological sample submitted to Department? Yes <input type="checkbox"/> No <input type="checkbox"/>	
<b>5 TYPE OF BLANK CASING USED:</b> <input checked="" type="checkbox"/> Steel <input type="checkbox"/> RMP (SR) <input type="checkbox"/> Wrought <input type="checkbox"/> Fiberglass <input type="checkbox"/> Other (Specify below) _____ <input type="checkbox"/> PVC <input type="checkbox"/> ABS <input type="checkbox"/> Asbestos-Cement <input type="checkbox"/> Concrete Tile Blank casing diameter <u>4</u> in. Was casing pulled? Yes <input type="checkbox"/> No <input type="checkbox"/> If yes, how much _____ Casing height above or below land surface _____ in.	
<b>6 GROUT PLUG MATERIAL:</b> <input type="checkbox"/> Neat cement <input type="checkbox"/> Cement grout <input type="checkbox"/> Bentonite <input type="checkbox"/> Other _____ Grout Plug Intervals: From _____ ft. to _____ ft., From _____ ft. to _____ ft., From _____ ft. to _____ ft. What is the nearest source of possible contamination: <input checked="" type="checkbox"/> Septic tank <input type="checkbox"/> Seepage pit <input type="checkbox"/> Fuel storage <input type="checkbox"/> Other (specify below) _____ <input type="checkbox"/> Sewer lines <input type="checkbox"/> Pit privy <input type="checkbox"/> Fertilizer storage <input type="checkbox"/> Watertight sewer lines <input type="checkbox"/> Sewage lagoon <input type="checkbox"/> Insecticide storage <input type="checkbox"/> Lateral lines <input type="checkbox"/> Feedyard <input type="checkbox"/> Abandoned water well Direction from well? <u>NW</u> <input type="checkbox"/> Cess pool <input type="checkbox"/> Livestock pens <input type="checkbox"/> Oil well/Gas well How many feet? <u>80</u>	
<table border="1" style="width:100%; border-collapse: collapse;"> <thead> <tr> <th>FROM</th> <th>TO</th> <th>PLUGGING MATERIALS</th> <th>FROM</th> <th>TO</th> <th>PLUGGING MATERIALS</th> </tr> </thead> <tbody> <tr> <td>0</td> <td>20</td> <td>Bentonite grout</td> <td></td> <td></td> <td></td> </tr> <tr> <td>20</td> <td>180</td> <td>Fill Sand</td> <td></td> <td></td> <td></td> </tr> <tr> <td>180</td> <td>200</td> <td>Bentonite grout</td> <td></td> <td></td> <td></td> </tr> <tr> <td>200</td> <td>240</td> <td>Fill Sand</td> <td></td> <td></td> <td></td> </tr> <tr> <td> </td> <td> </td> <td> </td> <td> </td> <td> </td> <td> </td> </tr> </tbody> </table>			FROM	TO	PLUGGING MATERIALS	FROM	TO	PLUGGING MATERIALS	0	20	Bentonite grout				20	180	Fill Sand				180	200	Bentonite grout				200	240	Fill Sand																					
FROM	TO	PLUGGING MATERIALS	FROM	TO	PLUGGING MATERIALS	
0	20	Bentonite grout	
20	180	Fill Sand	
180	200	Bentonite grout	
200	240	Fill Sand	
<b>7 CONTRACTOR'S OR LANDOWNER'S CERTIFICATION:</b> This water well was plugged under my jurisdiction and was completed on (mo/day/year) <u>7-25-13</u> and this record is true to the best of my knowledge and belief. Kansas Water Well Contractor's License No. <u>846</u> This Water Well Record was completed on (mo/day/year) <u>9-9-2013</u> under the business name of <u>Nash Water Well Service, LLC.</u> by (signature) <u>[Signature]</u>	
<b>INSTRUCTIONS:</b> Use typewriter or ballpoint pen. Please press firmly and print clearly. Please fill in blanks, underline or circle the correct answers. Send top three copies to Kansas Department of Health and Environment, Bureau of Water, Geology Section, 1000 SW Jackson St., Ste. 420, Topeka, Kansas 66612-1367. Telephone: 785/296-5524. Send one to Water Well Owner and retain one for your records. Visit us at <a href="http://www.kdheks.gov/waterwell/index.html">http://www.kdheks.gov/waterwell/index.html</a> .	