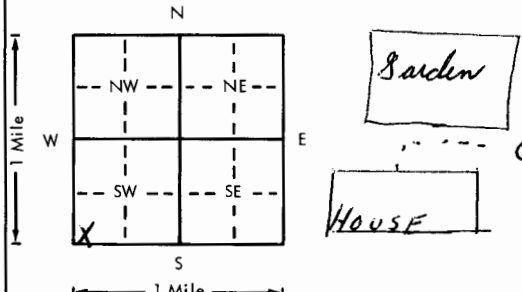


USE TYPEWRITER OR BALL  
POINT PEN-PRESS FIRMLY,  
PRINT CLEARLY.

WATER WELL RECORD  
KSA 82a-1201-1215

Kansas Department of Health and  
Environment-Division of Environment  
(Water well Contractors)  
Topeka, Kansas 66620

1. Location of well:		County <b>Ford</b>	Fraction <b>SW 1/4 SW 1/4 SW 1/4</b>	Section number <b>6</b>	Township number <b>T 29</b>	Range number <b>S R 26 E/W</b>
2. Distance and direction from nearest town or city: <b>7 miles south &amp; 1 mile east of Ensign, Kansas</b> Street address of well location if in city:				3. Owner of well: <b>Calab Sutton</b> R.R. or street: City, state, zip code: <b>Ensign, Kansas 67841</b>		
4. Locate with "X" in section below: 				6. Bore hole dia. <b>8</b> in. Completion date <b>12-11-77</b> Well depth <b>112</b> ft.		
				7. <input checked="" type="checkbox"/> Cable tool <input checked="" type="checkbox"/> Rotary <input type="checkbox"/> Driven <input type="checkbox"/> Dug <input type="checkbox"/> Hollow rod <input type="checkbox"/> Jetted <input type="checkbox"/> Bored <input type="checkbox"/> Reverse rotary		
				8. Use: <input checked="" type="checkbox"/> Domestic <input type="checkbox"/> Public supply <input type="checkbox"/> Industry <input type="checkbox"/> Irrigation <input type="checkbox"/> Air conditioning <input type="checkbox"/> Stock <input type="checkbox"/> Lawn <input type="checkbox"/> Oil field water <input type="checkbox"/> Other		
				9. Casing: Material <b>RMP</b> Height: Above <del>ground</del> Threaded <input type="checkbox"/> Welded <input type="checkbox"/> Surface <b>20</b> in. RMP <b>xx</b> PVC <input type="checkbox"/> Weight <input type="checkbox"/> lbs./ft. Dia. <b>5</b> in. to <b>112</b> ft. depth Wall Thickness: inches or Dia. <input type="checkbox"/> in. to <input type="checkbox"/> ft. depth gage No. <b>250</b>		
5. Type and color of material				From	To	10. Screen: Manufacturer's name <b>Sunflower</b> Type <b>RMP</b> Dia. <b>5</b> in. Slot/gauge <b>1/8</b> in. Length <b>20</b> ft. Set between <b>55</b> ft. and <b>107</b> ft. <input type="checkbox"/> ft. and <input type="checkbox"/> ft. Gravel pack? <b>yes</b> Size range of material <b>1/4</b> in.
Top soil & clay				0	15	11. Static water level: <input type="checkbox"/> mo./day/yr. <b>66</b> ft. below land surface Date <b>12-11-77</b>
Clay				15	45	12. Pumping level below land surfaces: <b>70</b> ft. after <b>3</b> hrs. pumping <b>18</b> g.p.m. <input type="checkbox"/> ft. after <input type="checkbox"/> hrs. pumping <input type="checkbox"/> g.p.m. Estimated maximum yield <b>27</b> g.p.m.
Clay & medium sand				45	60	13. Water sample submitted: <input type="checkbox"/> Yes <input checked="" type="checkbox"/> No Date <input type="checkbox"/>
Medium to coarse sand & clay				60	75	14. Well head completion: <input checked="" type="checkbox"/> Pitless adapter <b>12</b> inches above grade
Clay & medium sand layers				75	105	15. Well grouted? <b>yes</b> With: <input checked="" type="checkbox"/> Neat cement <input type="checkbox"/> Bentonite <input type="checkbox"/> Concrete Depth: From <b>7</b> ft. to <b>17</b> ft.
Clay & white (loose) rock				105	120	16. Nearest source of possible contamination: ft. <b>100</b> Direction <b>SE</b> Type <b>Sewer</b> Well disinfected upon completion? <input checked="" type="checkbox"/> Yes <input type="checkbox"/> No
Clay & blue shale				120	125	17. Pump: <input type="checkbox"/> Not installed Manufacturer's name <b>Goulds</b> Model number <b>EHB</b> HP <b>3/4</b> Volts <b>230</b> Length of drop pipe <b>95</b> ft. capacity <b>7</b> g.p.m. Type: <input checked="" type="checkbox"/> Submersible <input type="checkbox"/> Turbine <input type="checkbox"/> Jet <input type="checkbox"/> Reciprocating <input type="checkbox"/> Centrifugal <input type="checkbox"/> Other
(Use a second sheet if needed)						
18. Elevation:		19. Remarks:		20. Water well contractor's certification: This well was drilled under my jurisdiction and this report is true to the best of my knowledge and belief. <b>Joe's Well Service</b> <b>179</b> Business name License No. Address <b>Box 174 Cimarron, Ks.</b> Signed <b>Larry Chick</b> <b>12-26-77</b> Date Authorized representative		
Topography: <input type="checkbox"/> Hill <input checked="" type="checkbox"/> Slope <input type="checkbox"/> Upland <input type="checkbox"/> Valley						