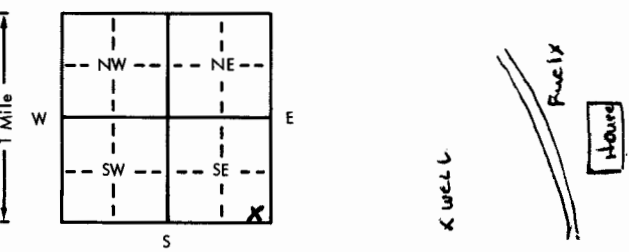


1. Location of well: County <u>FORD</u>		Fraction <u>SE 1/4 SE 1/4 SE 1/4</u>	Section number <u>20</u>	Township number <u>T 27</u>	Range number <u>S R 24</u>	E/W <u>E/W</u>
2. Distance and direction from nearest town or city: <u>9 miles N Fowler</u>			3. Owner of well: <u>DENNIS DECKER</u> R.R. or street: <u>Fowler, KS</u> City, state, zip code:			
4. Locate with "X" in section below: 			6. Bore hole dia. <u>8</u> in. Completion date <u>12/3/76</u> Well depth <u>200</u> ft.			
5. Type and color of material			7. <input checked="" type="checkbox"/> Cable tool <input checked="" type="checkbox"/> Rotary <input type="checkbox"/> Driven <input type="checkbox"/> Dug <input type="checkbox"/> Hollow rod <input type="checkbox"/> Jetted <input type="checkbox"/> Bored <input type="checkbox"/> Reverse rotary			
			8. Use: <input checked="" type="checkbox"/> Domestic <input type="checkbox"/> Public supply <input type="checkbox"/> Industry <input type="checkbox"/> Irrigation <input type="checkbox"/> Air conditioning <input type="checkbox"/> Stock <input type="checkbox"/> Lawn <input type="checkbox"/> Oil field water <input type="checkbox"/> Other			
			9. Casing: Material <u>PVC</u> Height: <u>Above</u> or below Threaded <input type="checkbox"/> Welded <input type="checkbox"/> Surface <u>16</u> in. RMP <input type="checkbox"/> PVC <u>PVC</u> Weight <u>250</u> lbs./ft. Dia. <u>5</u> in. to <u>200</u> ft. depth Wall Thickness: inches or Dia. <u>5</u> in. to <u>200</u> ft. depth Gauge No. <u>1250</u>			
			10. Screen: Manufacturer's name <u>Jess + Lowell</u> Type <u>PVC</u> Dia. <u>5</u> Gauge <u>1116</u> Length <u>3</u> Set between <u>200</u> ft. and <u>180</u> ft. <u>140</u> ft. and <u>130</u> ft. Gravel pack? <input checked="" type="checkbox"/> Size range of material <u>118</u>			
			11. Static water level: <u>77</u> ft. below land surface Date <u>3/15/76</u> mo./day/yr.			
			12. Pumping level below land surfaces: <u>NA</u> ft. after hrs. pumping g.p.m. ft. after hrs. pumping g.p.m. Estimated maximum yield g.p.m.			
			13. Water sample submitted: <u>Yes</u> <input checked="" type="checkbox"/> No <input type="checkbox"/> Date			
			14. Well head completion: <u>X</u> Pitless adapter <u>16</u> inches above grade			
			15. Well grouted? <u>yes</u> With: <input checked="" type="checkbox"/> Neat cement <input type="checkbox"/> Bentonite <input type="checkbox"/> Concrete Depth: From <u>3</u> ft. to <u>13</u> ft.			
			16. Nearest source of possible contamination: <u>200</u> ft. Direction <u>EAST</u> Type <u>SEASPOUL</u> Well disinfected upon completion? <input checked="" type="checkbox"/> Yes <input type="checkbox"/> No			
			17. Pump: Not installed Manufacturer's name <u>Reda</u> Model number <u>140108P</u> HP <u>1 1/2</u> Volts <u>220</u> Length of drop pipe <u>105</u> ft. capacity <u>20</u> g.p.m. Type: <input checked="" type="checkbox"/> Submersible <input type="checkbox"/> Turbine <input type="checkbox"/> Jet <input type="checkbox"/> Reciprocating <input type="checkbox"/> Centrifugal <input type="checkbox"/> Other			
			18. Elevation: <u>Level</u> Topography: <input checked="" type="checkbox"/> Hill <input checked="" type="checkbox"/> Slope <input type="checkbox"/> Upland <input type="checkbox"/> Valley			
19. Remarks:			20. Water well contractor's certification: This well was drilled under my jurisdiction and this report is true to the best of my knowledge and belief. <u>Crage Drilling</u> <u>111</u> Business Name License No. Address <u>411 DCK</u> Signed <u>Clay Dwyer</u> Date <u>12/3/76</u> Authorized representative			