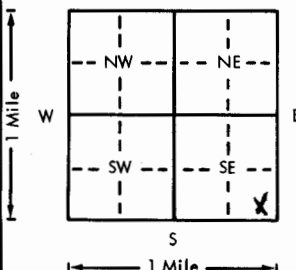
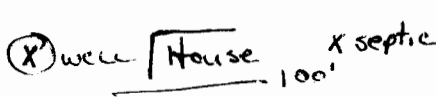


USE TYPEWRITER OR BALL  
POINT PEN-PRESS FIRMLY,  
PRINT CLEARLY.

WATER WELL RECORD  
KSA 82a-1201-1215

Kansas Department of Health and  
Environment-Division of Environment  
(Water well Contractors)  
Topeka, Kansas 66620

1. Location of well:		County <b>FORD</b>	Fraction <b>SE 1/4 SE 1/4 SE 1/4</b>	Section number <b>20</b>	Township number <b>T 29</b>	Range number <b>S R 26 E/W</b>
2. Distance and direction from nearest town or city: <b>10 N Fowler</b>			3. Owner of well: <b>O. J. Deavel</b>			
Street address of well location if in city:			R.R. or street: <b>Fowler KS 67844</b>			
4. Locate with "X" in section below:			Sketch map:			
						
5. Type and color of material			From	To	6. Bore hole dia. <b>8</b> in. Completion date <b>10/8/76</b> Well depth <b>200</b> ft.	
Topsoil			0	2	7. <input checked="" type="checkbox"/> Cable tool <input checked="" type="checkbox"/> Rotary <input type="checkbox"/> Driven <input type="checkbox"/> Dug <input type="checkbox"/> Hollow rod <input type="checkbox"/> Jetted <input type="checkbox"/> Bored <input type="checkbox"/> Reverse rotary	
Clay			2	45	8. Use: <input checked="" type="checkbox"/> Domestic <input type="checkbox"/> Public supply <input type="checkbox"/> Industry <input type="checkbox"/> Irrigation <input type="checkbox"/> Air conditioning <input type="checkbox"/> Stock <input type="checkbox"/> Lawn <input type="checkbox"/> Oil field water <input type="checkbox"/> Other	
GRAVEL			45	90	9. Casing: Material <b>R/C</b> Height: <b>above</b> or below Threaded <input type="checkbox"/> Welded <input type="checkbox"/> Surface <b>20</b> in. RMP <b>PVC Blue</b> Weight <b>250</b> lbs./ft. Dia. <b>5</b> in. to <b>200</b> ft. depth Wall Thickness: inches or Dia. <b>5</b> in. to <b>200</b> ft. depth gage No. <b>250</b>	
Clay			90	130	10. Screen: Manufacturer's name <b>Jess H. Lawen</b> Type <b>R/C</b> Dia. <b>5</b> Slot/gauze <b>1/4</b> Length <b>3</b> Set between <b>180</b> ft. and <b>200</b> ft. <b>130</b> ft. and <b>140</b> ft. Gravel pack? <input checked="" type="checkbox"/> Size range of material <b>1/8</b>	
GRAVEL			130	140	11. Static water level: <b>70</b> ft. below land surface Date <b>3/10/76</b> mo./day/yr.	
Clay & Sand			140	170	12. Pumping level below land surfaces: <b>NA</b> ft. after hrs. pumping g.p.m. ft. after hrs. pumping g.p.m. Estimated maximum yield g.p.m.	
GRAVEL			170	177	13. Water sample submitted: mo./day/yr. Yes <input checked="" type="checkbox"/> No <input type="checkbox"/> Date	
Rock			177	200	14. Well head completion: <input checked="" type="checkbox"/> Pitless adapter <b>20</b> inches above grade	
					15. Well grouted? <input checked="" type="checkbox"/> With: <input checked="" type="checkbox"/> Neat cement <input type="checkbox"/> Bentonite <input type="checkbox"/> Concrete Depth: From <b>3</b> ft. to <b>13</b> ft.	
					16. Nearest source of possible contamination: ft. <b>100</b> Direction <b>E</b> Type <b>Septic</b> Well disinfected upon completion? <input checked="" type="checkbox"/> Yes <input type="checkbox"/> No	
					17. Pump: Manufacturer's name <b>Reda</b> Not installed Model number <b>100108P</b> HP <b>1</b> Volts <b>220</b> Length of drop pipe <b>126</b> ft. capacity <b>20</b> g.p.m. Type: <input checked="" type="checkbox"/> Submersible <input type="checkbox"/> Turbine <input type="checkbox"/> Jet <input type="checkbox"/> Reciprocating <input type="checkbox"/> Centrifugal <input type="checkbox"/> Other	
18. Elevation: <b>hevel</b> Topography: <input type="checkbox"/> Hill <input type="checkbox"/> Slope <input type="checkbox"/> Upland <input type="checkbox"/> Valley			19. Remarks:		20. Water well contractor's certification: This well was drilled under my jurisdiction and this report is true to the best of my knowledge and belief. <b>CRAGG Drilling</b> <b>111</b> Business name License No. Address <b>RT 1 Dodge City KS</b> Signed <b>Clay Cragg</b> Date <b>3/10/76</b> Authorized representative	