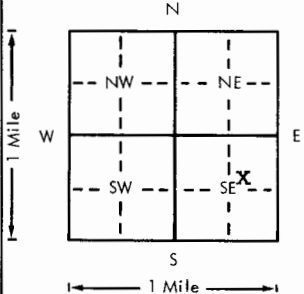


USE TYPEWRITER OR BALL  
POINT PEN-PRESS FIRMLY,  
PRINT CLEARLY.

WATER WELL RECORD  
KSA 82a-1201-1215

Kansas Department of Health and  
Environment-Division of Environment  
(Water well Contractors)  
Topeka, Kansas 66620

1. Location of well:		County <b>Ford</b>	Fraction <b>SW 1/4 NE 1/4 SE 1/4</b>	Section number <b>22</b>	Township number <b>T 29 S R 26 E W</b>	Range number <b>26</b>
2. Distance and direction from nearest town or city: <b>From Dodge City, Ks. 5W, 13S, 1W, 3/4S</b> Street address of well location if in city:				3. Owner of well: <b>D.A. Bartlett</b> R.R. or street: <b>Fowler, Kansas 67844</b> City, state, zip code:		
4. Locate with "X" in section below:		Sketch map:		6. Bore hole dia. <b>28</b> in. Completion date _____ Well depth <b>275</b> ft. <b>1-15-77</b>		
				7. Cable tool _____ Rotary _____ Driven _____ Dug _____ Hollow rod _____ Jetted _____ Bored <input checked="" type="checkbox"/> Reverse rotary		
5. Type and color of material		From To		8. Use: Domestic _____ Public supply _____ Industry _____ <input checked="" type="checkbox"/> Irrigation _____ Air conditioning _____ Stock _____ Lawn _____ Oil field water _____ Other _____		
Surface		0 3		9. Casing: Material <b>Steel</b> Height: Above or below _____ Threaded _____ Welded <input checked="" type="checkbox"/> Surface _____ 12 in. RMP _____ PVC _____ Weight _____ lbs./ft. Dia. <b>16</b> in. to <b>155</b> ft. depth Wall Thickness: inches _____ Dia. _____ in. to _____ ft. depth Gauge No. <b>188</b>		
Clay		3 55		10. Screen: Manufacturer's name <b>W. A. Brown</b> Type <b>Steel</b> Dia. <b>16</b> Slot/gauze <b>17%</b> Length <b>40'</b> Set between <b>155</b> ft. and <b>275</b> ft. _____ ft. and _____ Gravel pack? <b>yes</b> Size range of material <b>1/4 to 5/8</b>		
Sand & Clay		55 71		11. Static water level: _____ mo./day/yr. <b>68</b> ft. below land surface Date <b>11-6-76</b>		
Grey Clay and sand layers		71 87		12. Pumping level below land surfaces: <b>145</b> ft. after <b>3</b> hrs. pumping <b>1383</b> g.p.m. _____ ft. after _____ hrs. pumping _____ g.p.m. Estimated maximum yield <b>2200</b> g.p.m.		
Blue clay and sand layers		87 100		13. Water sample submitted: _____ mo./day/yr. Yes <input checked="" type="checkbox"/> No _____ Date _____		
Blue clay & grey clay		100 142		14. Well head completion: Pitless adapter _____ 12 Inches above grade		
Sand & Gravel		142 206		15. Well grouted? <b>yes</b> With: _____ Neat cement _____ Bentonite <input checked="" type="checkbox"/> Concrete _____ Depth: From <b>0</b> ft. to <b>10</b> ft.		
Clay & sand layers & caliche		206 232		16. Nearest source of possible contamination: ft. <b>1/4</b> mi Direction <b>SE</b> Type <b>Farm</b> Well disinfected upon completion? _____ Yes _____ No		
Sand rock		232 280		17. Pump: _____ Not installed Manufacturer's name <b>Western Land Roller</b> Model number <b>3-14CH</b> HP <b>100</b> Volts _____ Length of drop pipe <b>220</b> ft. capacity <b>1400</b> g.p.m. Type: _____ Submersible <input checked="" type="checkbox"/> Turbine _____ Jet _____ Reciprocating _____ Centrifugal _____ Other _____		
Sand & gravel with streaks of clay		280 329		20. Water well contractor's certification: This well was drilled under my jurisdiction and this report is true to the best of my knowledge and belief. <b>Woofert Drilling Inc 343</b> Business name _____ License No. _____ Address <b>Hwy 56, Dodge City, Ks</b> Signed <b>Michael D. Woofert</b> Date <b>12/11/77</b> Authorized representative		
Shale		329 330				
(Use a second sheet if needed)						
18. Elevation:		19. Remarks:				
Topography: Hill _____ Slope _____ <input checked="" type="checkbox"/> Upland _____ Valley _____						