USE TYPEWRITER OR BALL POINT PEN-PRESS FIRMLY, PRINT CLEARLY.

T R EW sec 1/4 1/4 1/4 No.

WATER WELL RECORD
KSA 82a-1201-1215

Kansas State Dept. Of Health
(Water Well Contractors)
Forbes-Bldg. 740
Topeka, Kansas 66620

1 Location of well:	County	Township name	Fraction	Section number	Town number	Range number
	Ford	Wilburn	SE¼ -30	30	T-29	R-26-W

Distance and direction from nearest town or city:
7¼ mi north and ¼ west of Fowler, Ks
Street address of well location if in city:

3 Owner of well: Louis Haywood
Address: Rt 2, Emporia, Kansas

Locate with "X" in section below: Sketch map:

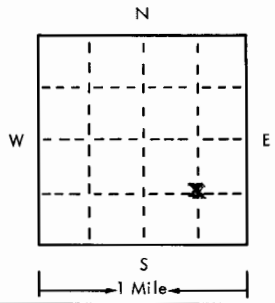

4 Well depth: 275 ft. Date of completion 12-20-74
Well diameter 26 in.

5 ☐ Cable tool ☐ Rotary ☐ Driven ☐ Dug
☐ Hollow rod ☐ Jetted ☐ Bored ☒ Reverse rotary

6 Use: ☐ Domestic ☐ Public supply ☐ Industry
☒ Irrigation ☐ Air conditioning ☐ Commercial
☐ Test well ☐ _____

7 Casing: Material _____ Height: above/below
Threaded ☐ Welded ☐ Surface _____ in.
Diam. Weight _____ lbs./ft.
____ in. to ____ ft. depth Drive shoe? ☐ Yes ☐ No
____ in. to ____ ft. depth

2 Type and color of material	From	To
(use a second sheet if needed)		

8 Screen:
Manufacturer _____
Type _____ Dia. _____
Slot/gauze _____ Length _____
Set between ____ ft. and ____ ft.
Fittings:
Gravel pack ☐ Yes ☐ No Size range of material ____

9 Static water level: NA
____ ft. below land surface Date _____

10 Pumping level below land surfaces: NA
____ ft. after ____ hrs. pumping ____ g.p.m.
____ ft. after ____ hrs. pumping ____ g.p.m.
Estimated maximum yield ____ g.p.m.

11 Water sample submitted:
☐ Yes ☐ No Date _____

12 Well head completion:
☐ Pitless adapter ☐ Inches above grade

13 Well grouted? ☐ Yes ☐ No
☐ Neat cement ☐ Bentonite ☐ _____
Depth: From ____ ft. to ____ ft.

14 Nearest source of possible contamination:
ft. _____ Direction _____ Type _____
Well disinfected upon completion? ☐ Yes ☐ No

15 Pump: 3-13-75 ☐ Not installed
Manufacturer's name Goulds
Model number 10JHC HP 60 Volts ____
Length of drop pipe 160 ft. capacity 600 g.m.p.
Type:
☐ Submersible ☒ Turbine
☐ Jet ☐ Reciprocating
☐ Certrifugal ☐ Other

16 Remarks: elevation

Topography:
☐ Hill
☐ Slope
☒ Upland
☐ Valley

17 Water well contractor's certification:
This well was drilled under my jurisdiction and this report is true to the best of my knowledge and belief.
Ace-Hi Drilling Co 190
Business name License No.
Address Box 1442, Dodge City, Ks
Signed Earl C. Little Date 3-13-75
Authorized representative

Forward the white, blue and pink copies to the Kansas State Dept. Of Health.

Form WWC-5