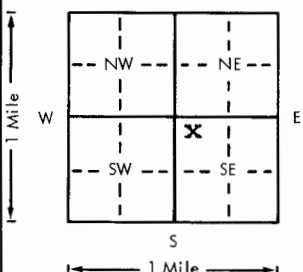


USE TYPEWRITER OR BALL  
POINT PEN-PRESS FIRMLY,  
PRINT CLEARLY.

WATER WELL RECORD  
KSA 82a-1201-1215

Kansas Department of Health and  
Environment-Division of Environment  
(Water well Contractors)  
Topeka, Kansas 66620

X Location of well:		County <u>Jord</u>	Fraction <u>NW 1/4 NW 1/4 SE 1/4</u>	Section number <u>31</u>	Township number <u>T 29 S</u>	Range number <u>R 26 E/W</u>
X Distance and direction from nearest town or city: <u>6 1/2 N &amp; 3/8 W of Fowler, Kansas</u>				3. Owner of well: <u>Larry &amp; Ralph Sturgeon</u>		
Street address of well location if in city:				R.R. or street: City, state, zip code: <u>Fowler, Kansas</u>		
4. Locate with "X" in section below:		Sketch map:		6. Bore hole dia. <u>28</u> in. Completion date <u>11-20-76</u> Well depth <u>210</u> ft.		
				7. Cable tool <input type="checkbox"/> Rotary <input type="checkbox"/> Driven <input type="checkbox"/> Dug <input type="checkbox"/> <input type="checkbox"/> Hollow rod <input type="checkbox"/> Jetted <input type="checkbox"/> Bored <input checked="" type="checkbox"/> Reverse rotary		
5. Type and color of material				From	To	
Surface				0	2	
Clay				2	46	
Clay & Caliche				46	48	
Clay				48	52	
Fine Sand				52	57	
Gray Clay				57	94	
Fine sand				94	104	
Clay				104	112	
Med. sand - some small gravel				112	155	
Clay				155	156	
Sand & Gravel				156	207	
Heavy Clay				207	210	
(Use a second sheet if needed)						
18. Elevation:		19. Remarks:		20. Water well contractor's certification: This well was drilled under my jurisdiction and this report is true to the best of my knowledge and belief. <u>Woofter Drilling, Inc. 343</u> Business name License No. Address <u>Hwy 56, Dodge City, Ks</u> Signed <u>Madeline D. [Signature]</u> Date <u>12/11/76</u> Authorized representative		
Topography: <input type="checkbox"/> Hill <input type="checkbox"/> Slope <input checked="" type="checkbox"/> Upland <input type="checkbox"/> Valley						

29 26 31  
K  
Sec  
1/4 1/4 1/4