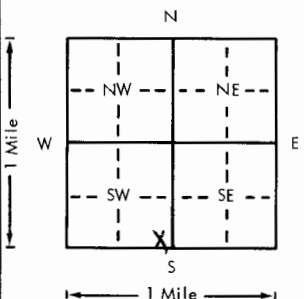


USE TYPEWRITER OR BALL
POINT PEN-PRESS FIRMLY,
PRINT CLEARLY.

WATER WELL RECORD
KSA 82a-1201-1215

Kansas Department of Health and
Environment-Division of Environment
(Water well Contractors)
Topeka, Kansas 66620

| | | | | | | |
|---|--|-----------------------|---|---|--------------------------------|-----------------------------------|
| 1. Location of well: | | County Ford | Fraction SE 1/4 SE 1/4 SW 1/4 | Section number 32 | Township number T 29 | Range number S R 26 E/W |
| 2. Distance and direction from nearest town or city: 1 1/2 miles South of Ensign and 2 1/2 miles East Street address of well location if in city: | | | 3. Owner of well: Ralph Sturgeon R.R. or street: 1311 2nd City, state, zip code: Dodge City, Kansas 67801 | | | |
| 4. Locate with "X" in section below: | | Sketch map: | | 6. Bore hole dia. 8 in. Completion date 6-1-79 Well depth 215 ft. | | |
|  | | | | 7. <input checked="" type="checkbox"/> Cable tool <input checked="" type="checkbox"/> Rotary <input type="checkbox"/> Driven <input type="checkbox"/> Dug <input type="checkbox"/> Hollow rod <input type="checkbox"/> Jetted <input type="checkbox"/> Bored <input type="checkbox"/> Reverse rotary | | |
| 5. Type and color of material | | From | To | 8. Use: <input checked="" type="checkbox"/> Domestic <input type="checkbox"/> Public supply <input type="checkbox"/> Industry <input type="checkbox"/> Irrigation <input type="checkbox"/> Air conditioning <input type="checkbox"/> Stock <input type="checkbox"/> Lawn <input type="checkbox"/> Oil field water <input type="checkbox"/> Other | | |
| Top soil & clay | | 0 | 15 | 9. Casing: Material RMP Height: Above or below Threaded <input type="checkbox"/> Welded <input type="checkbox"/> Surface 12 in. RMP <input checked="" type="checkbox"/> PVC <input type="checkbox"/> Weight <input type="checkbox"/> lbs./ft. Dia. 5 in. to 215 ft. depth Wall Thickness: inches or Dia. <input type="checkbox"/> in. to <input type="checkbox"/> ft. depth Gauge No. 250 | | |
| Clay | | 15 | 75 | 10. Screen: Manufacturer's name Jess & Lovell Type RMP Dia. 5 1/2 Slot/gauze 1/8" Length 20 ft. Set between 190 ft. and 210 ft. ft. and <input type="checkbox"/> ft. | | |
| Clay & Sand fine in layers | | 75 | 90 | Gravel pack? YES Size range of material 4" | | |
| | | 90 | 105 | 11. Static water level: <input type="checkbox"/> mo./day/yr. 75 ft. below land surface Date 6-27-79 | | |
| Bleu clay | | 105 | 120 | 12. Pumping level below land surfaces: 80 ft. after 1 hrs. pumping 60 g.p.m. ft. after <input type="checkbox"/> hrs. pumping <input type="checkbox"/> g.p.m. Estimated maximum yield 70 g.p.m. | | |
| Blue clay & fine sand | | 120 | 135 | 13. Water sample submitted: <input type="checkbox"/> mo./day/yr. <input type="checkbox"/> Yes <input checked="" type="checkbox"/> No Date <input type="checkbox"/> | | |
| Fine sand | | 135 | 150 | 14. Well head completion: <input checked="" type="checkbox"/> Pitless adapter 12 inches above grade | | |
| Fine sand to medium sand | | 150 | 165 | 15. Well grouted? yes With: <input checked="" type="checkbox"/> Neat cement <input type="checkbox"/> Bentonite <input type="checkbox"/> Concrete Depth: From 10 ft. to 25 ft. | | |
| Medium sand | | 165 | 180 | 16. Nearest source of possible contamination: none ft. <input type="checkbox"/> Direction <input type="checkbox"/> Type <input type="checkbox"/> Well disinfected upon completion? <input checked="" type="checkbox"/> Yes <input type="checkbox"/> No | | |
| Medium sand to coarse sand | | 180 | 195 | 17. Pump: <input type="checkbox"/> Not installed Manufacturer's name Flint & Walling Model number 15BK12 HP 1 1/2 Volts 220 Length of drop pipe 11.7 ft. capacity 15 g.p.m. Type: <input checked="" type="checkbox"/> Submersible <input type="checkbox"/> Turbine <input type="checkbox"/> Jet <input type="checkbox"/> Reciprocating <input type="checkbox"/> Centrifugal <input type="checkbox"/> Other | | |
| | | 195 | 210 | | | |
| Medium to coarse sand & clay | | 210 | 225 | | | |
| | | | | | | |
| | | | | | | |
| (Use a second sheet if needed) | | | | | | |
| 18. Elevation: | 19. Remarks: New building site | | 20. Water well contractor's certification: This well was drilled under my jurisdiction and this report is true to the best of my knowledge and belief. Joe's Well Service 179 Business name License No. Address Box 174 Cimarron, Ks. Signed Paul Crick Date 7-11-79 Authorized representative | | | |
| Topography: <input type="checkbox"/> Hill <input type="checkbox"/> Slope <input checked="" type="checkbox"/> Upland <input type="checkbox"/> Valley | | | | | | |

29
240
32
SE
1/4
1/4
1/4