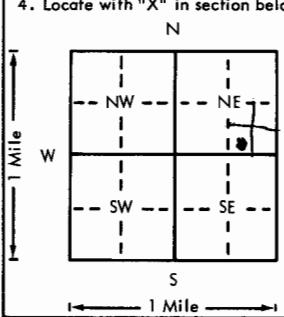


USE TYPEWRITER OR BALL
POINT PEN-PRESS FIRMLY,
PRINT CLEARLY.

WATER WELL RECORD
KSA 82a-1201-1215

Kansas Department of Health and
Environment-Division of Environment
(Water well Contractors)
Topeka, Kansas 66620

1. Location of well:	County <i>Gray</i>	Fraction <i>SW 1/4 SE 1/4 NE 1/4</i>	Section number <i>3</i>	Township number <i>T 29</i>	Range number <i>S R 27</i>	E/W	
2. Distance and direction from nearest town or city: <i>Hazzard 8 1/2 E - S</i>	Street address of well location if in city:		3. Owner of well: <i>Andy Macnow</i> R.R. or street: <i>Ensign Kansas</i> City, state, zip code:				
4. Locate with "X" in section below: 		Sketch map: <i>shed</i> <i>garage</i> <i>well</i> <i>barn</i> <i>gas barrels</i>	6. Bore hole dia. <u>8 3/8</u> in. Completion date <u>5/15/78</u> Well depth <u>110</u> ft.				
			7. <input type="checkbox"/> Cable tool <input checked="" type="checkbox"/> Rotary <input type="checkbox"/> Driven <input type="checkbox"/> Dug <input type="checkbox"/> Hollow rod <input type="checkbox"/> Jetted <input type="checkbox"/> Bored <input type="checkbox"/> Reverse rotary				
			8. Use: <input checked="" type="checkbox"/> Domestic <input type="checkbox"/> Public supply <input type="checkbox"/> Industry <input type="checkbox"/> Irrigation <input type="checkbox"/> Air conditioning <input type="checkbox"/> Stock <input type="checkbox"/> Lawn <input type="checkbox"/> Oil field water <input type="checkbox"/> Other				
			9. Casing: Material _____ Height: Above or below Threaded _____ Welded _____ Surface _____ in. RMP _____ PVC <input checked="" type="checkbox"/> Weight _____ lbs./ft. Dia. <u>5</u> in. to <u>100</u> ft. depth Wall Thickness: inches or Dia. _____ in. to _____ ft. depth Gage No. _____				
			10. Screen: Manufacturer's name <u>jet stream</u> Type <u>PVC</u> Dia. <u>5</u> Slot/gauze <u>1/8"</u> Length <u>40</u> Set between <u>70</u> ft. and <u>110</u> ft. ft. and _____ ft. Gravel pack? <input checked="" type="checkbox"/> Size range of material <u>5-10</u>				
			11. Static water level: <u>78</u> ft. below land surface Date <u>5/15/78</u> mo./day/yr.				
			12. Pumping level below land surfaces: <u>88</u> ft. after <u>1</u> hrs. pumping <u>20</u> g.p.m. ft. after _____ hrs. pumping _____ g.p.m. Estimated maximum yield <u>20</u> g.p.m.				
			13. Water sample submitted: <input type="checkbox"/> Yes <input checked="" type="checkbox"/> No Date _____ mo./day/yr.				
			14. Well head completion: <input checked="" type="checkbox"/> Pitless adapter _____ Inches above grade				
			15. Well grouted? <input checked="" type="checkbox"/> With: _____ Neat cement <input type="checkbox"/> Bentonite <input checked="" type="checkbox"/> Concrete Depth: From <u>5</u> ft. to <u>15</u> ft.				
			16. Nearest source of possible contamination: ft. <u>100</u> Direction <u>north</u> Type <u>fuel</u> Well disinfected upon completion? <input checked="" type="checkbox"/> Yes _____ No _____				
			17. Pump: Not installed Manufacturer's name <u>Flint + Walling</u> Model number <u>103A9</u> HP <u>1/2</u> Volts <u>270</u> Length of drop pipe _____ ft. capacity <u>19</u> g.p.m. Type: <input checked="" type="checkbox"/> Submersible <input type="checkbox"/> Turbine <input type="checkbox"/> Jet <input type="checkbox"/> Reciprocating <input type="checkbox"/> Centrifugal <input type="checkbox"/> Other				
		(Use a second sheet if needed)					
18. Elevation:	19. Remarks:						
Topography: <input type="checkbox"/> Hill <input type="checkbox"/> Slope <input type="checkbox"/> Upland <input type="checkbox"/> Valley							
20. Water well contractor's certification: This well was drilled under my jurisdiction and this report is true to the best of my knowledge and belief. <i>Bald Eagle</i> <i>101A</i> Business name _____ License No. _____ Address <i>Meade Kansas</i> Signed <i>John Barta</i> Date <i>6-11-78</i> Authorized representative _____							