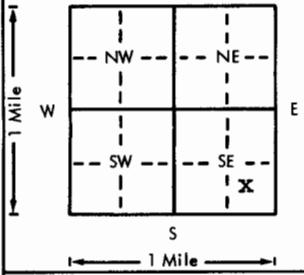


USE TYPEWRITER OR BALL  
POINT PEN-PRESS FIRMLY,  
PRINT CLEARLY.

WATER WELL RECORD  
KSA 82a-1201-1215

Kansas Department of Health and  
Environment-Division of Environment  
(Water well Contractors)  
Topeka, Kansas 66620

1. Location of well:	County Gray	Fraction NE 1/4 SE 1/4 SE 1/4	Section number 20	Township number T 29	Range number S R 29 28 E 0
2. Distance and direction from nearest town or city: Street address of well location if in city:	3 <del>East</del> & 5 south of Montezuma, Kansas		3. Owner of well: R.R. or street: City, state, zip code: Ernest Unruh RFD Montezuma, Kansas 67867		
4. Locate with "X" in section below:	Sketch map: 		6. Bore hole dia. 9 7/8 in. Completion date _____ Well depth 319 ft. 8-29-77		
5. Type and color of material	From	To	7. <input checked="" type="checkbox"/> Cable tool <input checked="" type="checkbox"/> Rotary <input type="checkbox"/> Driven <input type="checkbox"/> Dug <input type="checkbox"/> Hollow rod <input type="checkbox"/> Jetted <input type="checkbox"/> Bored <input type="checkbox"/> Reverse rotary		
Top soil	0	4	8. Use: <input checked="" type="checkbox"/> Domestic <input type="checkbox"/> Public supply <input type="checkbox"/> Industry <input type="checkbox"/> Irrigation <input type="checkbox"/> Air conditioning <input type="checkbox"/> Stock <input type="checkbox"/> Lawn <input type="checkbox"/> Oil field water <input type="checkbox"/> Other		
Sandy clay	4	80	9. Casing: Material <input checked="" type="checkbox"/> PVC <input type="checkbox"/> Height: Above or below Threaded <input type="checkbox"/> Welded <input checked="" type="checkbox"/> Surface 12 in. RMP <input type="checkbox"/> PVC <input checked="" type="checkbox"/> Weight 2.8 lbs./ft. Dia. 5 in. to 319 ft. depth Wall thickness: inches or Dia. in. to ft. depth gage No. 265		
Med. to lar. sand (some gravel)	80	330	10. Screen: Manufacturer's name Jess & Lowell Type <input checked="" type="checkbox"/> PVC Dia. 5" Slot/ <del>area</del> 1/8" Length 60' Set between 259 ft. and 319 ft. ft. and ft. Gravel pack? <input checked="" type="checkbox"/> Yes Size range of material 1/64-5/32		
			11. Static water level: mo./day/yr. 103 ft. below land surface Date 8/24/77		
			12. Pumping level below land surfaces: 104 ft. after 1 hrs. pumping 60 g.p.m. ft. after hrs. pumping g.p.m. Estimated maximum yield 70+ g.p.m.		
			13. Water sample submitted: mo./day/yr. Yes <input checked="" type="checkbox"/> No Date		
			14. Well head completion: <input type="checkbox"/> Pitless adapter <input checked="" type="checkbox"/> 12 Inches above grade		
			15. Well grouted? <input checked="" type="checkbox"/> Yes With: <input checked="" type="checkbox"/> Neat cement <input type="checkbox"/> Bentonite <input type="checkbox"/> Concrete Depth From 0 ft. to 10 ft.		
			16. Nearest source of possible contamination: ft. 10 Direction east Type well Well disinfected upon completion? <input checked="" type="checkbox"/> Yes <input type="checkbox"/> No		
			17. Pump: <input checked="" type="checkbox"/> Transferred Not installed Manufacturer's name <input checked="" type="checkbox"/> customers Windmill Model number HP Volts Length of drop pipe 122 ft. capacity 3 g.p.m. Type: <input type="checkbox"/> Submersible <input type="checkbox"/> Turbine <input type="checkbox"/> Jet <input type="checkbox"/> Reciprocating <input type="checkbox"/> Centrifugal <input checked="" type="checkbox"/> Other		
(Use a second sheet if needed)			20. Water well contractor's certification: This well was drilled under my jurisdiction and this report is true to the best of my knowledge and belief. Friesen Windmill 252 Business name <input checked="" type="checkbox"/> License No. Address Meade, Kansas 67864 Signed <input checked="" type="checkbox"/> Date 9-7-77 Authorized representative		
18. Elevation:	19. Remarks:				
Topography: <input type="checkbox"/> Hill <input type="checkbox"/> Slope <input checked="" type="checkbox"/> Upland <input type="checkbox"/> Valley					