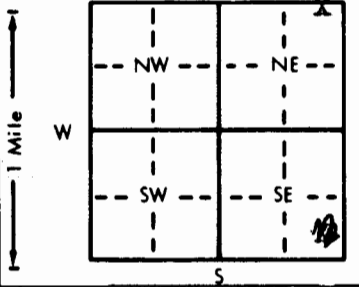


1 LOCATION OF WATER WELL:		Fraction	Section Number	Township Number	Range Number
County: GRAY		1/4 NE 1/4 NE 1/4	13	T 29 S	R 29 E/W
Distance and direction from nearest town or city street address of well if located within city? 4 MILES SOUTH OF SE CORNER OF MONTEAUMA					
2 WATER WELL OWNER:					
RR#, St. Address, Box #		BARTON KOEHN		Board of Agriculture, Division of Water Resources	
City, State, ZIP Code		MONTEAUMA, KS.		Application Number:	
3 LOCATE WELL'S LOCATION WITH AN "X" IN SECTION BOX:		4 DEPTH OF COMPLETED WELL: 146 ft. ELEVATION:			
		Depth(s) Groundwater Encountered 1. ft. 2. ft. 3. ft.			
		WELL'S STATIC WATER LEVEL 112 ft. below land surface measured on mo/day/yr 7/14/88			
		Pump test data: Well water was ft. after hours pumping gpm			
		Est. Yield gpm: Well water was ft. after hours pumping gpm			
		Bore Hole Diameter 9.7/8 in. to 146 ft. and in. to ft.			
TYPE OF BLANK CASING USED:		CASING JOINTS: Glued <input checked="" type="checkbox"/> Clamped			
1 Steel		3 RMP (SR)	6 Asbestos-Cement	9 Other (specify below)	Welded
<input checked="" type="checkbox"/> PVC		4 ABS	7 Fiberglass		Threaded
Blank casing diameter 5 in. to 146 ft. Dia. in. to ft. Dia. in. to ft.					
Casing height above land surface 20 in. weight 200 lbs./ft. Wall thickness or gauge No.					
TYPE OF SCREEN OR PERFORATION MATERIAL:		<input checked="" type="checkbox"/> PVC			
1 Steel		3 Stainless steel	5 Fiberglass	8 RMP (SR)	11 Other (specify)
2 Brass		4 Galvanized steel	6 Concrete tile	9 ABS	12 None used (open hole)
SCREEN OR PERFORATION OPENINGS ARE:		5 Gauzed wrapped			
1 Continuous slot		<input checked="" type="checkbox"/> Mill slot	6 Wire wrapped	8 Saw cut	11 None (open hole)
2 Louvered shutter		4 Key punched	7 Torch cut	9 Drilled holes	
SCREEN-PERFORATED INTERVALS:		10 Other (specify)			
From 106 ft. to 146 ft.		From ft. to ft.			
GRAVEL PACK INTERVALS:		From 40 ft. to 146 ft.			
From ft. to ft.		From ft. to ft.			
6 GROUT MATERIAL: 1 Neat cement 2 Cement grout <input checked="" type="checkbox"/> Bentonite 4 Other					
Grout intervals: From 4 ft. to 30 ft. From ft. to ft. From ft. to ft.					
What is the nearest source of possible contamination:					
<input checked="" type="checkbox"/> Septic tank		4 Lateral lines	7 Pit privy	10 Livestock pens	14 Abandoned water well
2 Sewer lines		5 Cess pool	8 Sewage lagoon	11 Fuel storage	15 Oil well/Gas well
3 Watertight sewer lines		6 Seepage pit	9 Feedyard	12 Fertilizer storage	16 Other (specify below)
Direction from well? south		How many feet? 100			
FROM	TO	LITHOLOGIC LOG	FROM	TO	PLUGGING INTERVALS
0	8	TOP SOIL			
8	21	BROWN SANDY CLAY			
21	32	FINE SAND			
32	50	BROWN SANDY CLAY AND RICK			
50	94	FINE TO MED SAND AND GRAVEL			
94	107	BROWN SANDY CLAY			
107	112	FINE TO MED SAND AND GRAVEL			
112	122	BROWN SANDY CLAY			
122	127	FINE TO MED SAND			
127	128	BROWN SANDY CLAY			
128	146	FINE TO MED SAND AND GRAVEL			
7 CONTRACTOR'S OR LANDOWNER'S CERTIFICATION: This water well was (1) constructed, (2) reconstructed, or (3) plugged under my jurisdiction and was completed on (mo/day/year) 8/1/88 and this record is true to the best of my knowledge and belief. Kansas Water Well Contractor's License No. 172 This Water Well Record was completed on (mo/day/yr) 6/1/88 under the business name of JONAGAN DRILLING CO. by (signature)					
INSTRUCTIONS: Use typewriter or ball point pen. PLEASE PRESS FIRMLY and PRINT clearly. Please fill in blanks, underline or circle the correct answers. Send top three copies to Kansas Department of Health and Environment, Bureau of Water Protection, Topeka, Kansas 66620-7320. Telephone: 913-296-5514. Send one to WATER WELL OWNER and retain one for your records.					