

WATER WELL RECORD Form WWC-5 KSA 82a-1212

| | | | | | |
|---------------------------|--|----------------------------------|--------------------------|---------------------------|--------------------------------|
| 1 LOCATION OF WATER WELL: | | Fraction <i>SW 1/4 SW 1/4</i> | Section Number " (29) | Township Number T 29 S | Range Number R 29 <i>EW</i> |
|---------------------------|--|----------------------------------|--------------------------|---------------------------|--------------------------------|

County: GRAY

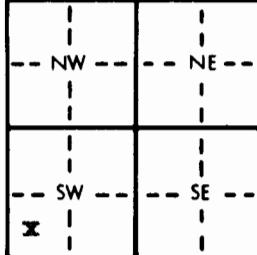
Distance and direction from nearest town or city street address of well if located within city?

8 MILES SOUTH HWY 56 EAST OF MONTEZUMA 1 M. EAST, 200 FT. NORTH

2 WATER WELL OWNER:

RR#, St. Address, Box # : DALLAS KOEHN
City, State, ZIP Code : MONTEZUMA, KS.Board of Agriculture, Division of Water Resources
Application Number:

| | | |
|--|--|---|
| 3 LOCATE WELL'S LOCATION WITH AN "X" IN SECTION BOX: | | 4 DEPTH OF COMPLETED WELL..... 205 ft. ELEVATION: |
|--|--|---|

| | | |
|---|--|---|
|  | | Depth(s) Groundwater Encountered 1..... ft. 2..... ft. 3..... ft. 9/14/81 |
| | | WELL'S STATIC WATER LEVEL .. 85 ft. below land surface measured on mo/day/yr |
| | | Pump test data: Well water was ft. after hours pumping gpm |
| | | Est. Yield gpm: Well water was ft. after hours pumping gpm |
| | | Bore Hole Diameter .. 9 7/8 in. to .. 215 ft. and in. to |
| | | WELL WATER TO BE USED AS: 5 Public water supply 8 Air conditioning 11 Injection well ★ Domestic 3 Feedlot 6 Oil field water supply 9 Dewatering 12 Other (Specify below) 2 Irrigation 4 Industrial 7 Lawn and garden only 10 Observation well |
| | | Was a chemical/bacteriological sample submitted to Department? Yes..... No..... X..... If yes, mo/day/yr sample was submitted |
| | | Water Well Disinfected? Yes <input checked="" type="checkbox"/> No <input type="checkbox"/> |

| | | |
|---|------------|---|
| 5 TYPE OF BLANK CASING USED: | | 5 Wrought iron 8 Concrete tile CASING JOINTS: Glued <input checked="" type="checkbox"/> Clamped |
| 1 Steel | 3 RMP (SR) | 6 Asbestos-Cement 9 Other (specify below) Welded |
| <input checked="" type="checkbox"/> PVC | 4 ABS | 7 Fiberglass Threaded |

Blank casing diameter .. 5 in. to .. 185 ft., Dia .. in. to ft., Dia .. in. to ft.

Casing height above land surface .. 18 in., weight .. 200 lbs./ft. Wall thickness or gauge No.

| | | |
|---|--------------------|--|
| TYPE OF SCREEN OR PERFORATION MATERIAL: | | ★ PVC 10 Asbestos-cement |
| 1 Steel | 3 Stainless steel | 5 Fiberglass 8 RMP (SR) 11 Other (specify) |
| 2 Brass | 4 Galvanized steel | 6 Concrete tile 9 ABS 12 None used (open hole) |

| | | |
|-------------------------------------|---------------|--|
| SCREEN OR PERFORATION OPENINGS ARE: | | 5 Gauzed wrapped 8 Saw cut 11 None (open hole) |
| 1 Continuous slot | 3 Mill slot | 6 Wire wrapped 9 Drilled holes |
| 2 Louvered shutter | 4 Key punched | 7 Torch cut 10 Other (specify) |

SCREEN-PERFORATED INTERVALS: From .. 185 ft. to .. 205 ft., From ft. to ft.

From ft. to ft., From ft. to ft.

GRAVEL PACK INTERVALS: From ft. to ft., From ft. to ft.

From ft. to ft., From ft. to ft.

6 GROUT MATERIAL: 1 Neat cement 2 Cement grout 3 Bentonite 4 Other

Grout Intervals: From .. 4 ft. to .. 25 ft., From ft. to ft., From ft. to ft.

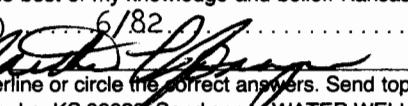
What is the nearest source of possible contamination:

| | | | | |
|--------------------------|-----------------|-----------------|-----------------------|--|
| 1 Septic tank | 4 Lateral lines | 7 Pit privy | 10 Livestock pens | 14 Abandoned water well |
| 2 Sewer lines | 5 Cess pool | 8 Sewage lagoon | 11 Fuel storage | 15 Oil well/Gas well |
| 3 Watertight sewer lines | 6 Seepage pit | 9 Feedyard | 12 Fertilizer storage | 16 Other (specify below) FARM BUILDING |

Direction from well? WEST How many feet? 20

| FROM | TO | LITHOLOGIC LOG | FROM | TO | LITHOLOGIC LOG |
|------|-----|--------------------------------|------|----|----------------|
| 0 | 10 | TOP SOIL | | | |
| 10 | 20 | BROWN SANDY CLAY | | | |
| 20 | 26 | HARD ROCK | | | |
| 26 | 50 | BROWN CLAY | | | |
| 40 | 61 | BROWN SANDY CLAY | | | |
| 61 | 72 | FINE SAND AND CLAY | | | |
| 72 | 80 | BROWN SANDY CLAY AND GRAY CLAY | | | |
| 80 | 103 | FINE TO MED SAND AND GRAVEL | | | |
| 103 | 106 | BROWN SANDY CLAY | | | |
| 106 | 107 | HARD ROCK | | | |
| 107 | 112 | BROWN SANDY CLAY | | | |
| 112 | 205 | FINE TO MED SAND AND GRAVEL | | | |

7 CONTRACTOR'S OR LANDOWNER'S CERTIFICATION: This water well was (1) constructed, (2) reconstructed, or (3) plugged under my jurisdiction and was completed on (mo/day/year) .. 9/14/81 .. and this record is true to the best of my knowledge and belief. Kansas

Water Well Contractor's License No. .. 172 .. This Water Well Record was completed on (mo/day/yr) .. 6/82 .. under the business name of JONAGAN DRILLING CO. by (signature) 

INSTRUCTIONS: Use typewriter or ball point pen, PLEASE PRESS FIRMLY and PRINT clearly. Please fill in blanks, underline or circle the correct answers. Send top three copies to Kansas Department of Health and Environment, Division of Environment, Environmental Geology Section, Topeka, KS 66620. Send one to WATER WELL OWNER and retain one for your records.