WATER WELL RECORD Form WWC-5 KSA 82a-1212 ID No. _____

1 LOCATION OF WATER WELL:	Fraction	Section Number	Township Number	Range Number
County: Gray	NE ¼ SE ¼ NE¼	13	T 29 S	R 29 E/W

Distance and direction from nearest town or city street address of well if located within city?
4 3/4 Mile South on road East side of Montezuma, Kansas

2 WATER WELL OWNER: Mr. Barton Koehn
RR#, St. Address, Box # : 33305 13 Road
City, State, ZIP Code : Mo Montezuma, Kansas 67867
Board of Agriculture, Division of Water Resources Application Number:

3 LOCATE WELL'S LOCATION WITH AN "X" IN SECTION BOX:

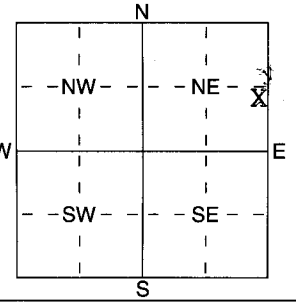

4 DEPTH OF COMPLETED WELL 390 ft. ELEVATION:
Depth(s) Groundwater Encountered 1 127 ft. 2 330 ft. 3 ft.
WELL'S STATIC WATER LEVEL 125 ft. below land surface measured on mo/day/yr 1-28-05
Pump test data: Well water was ft. after hours pumping gpm
Est. Yield 16 gpm: Well water was ft. after hours pumping gpm
WELL WATER TO BE USED AS: 1 Domestic 2 Irrigation 3 Feedlot 4 Industrial 5 Public water supply 6 Oil field water supply 7 Domestic (lawn & garden) 8 Air conditioning 9 Dewatering 10 Monitoring well 11 Injection well 12 Other (Specify below)

Was a chemical/bacteriological sample submitted to Department? Yes ..... No X ; If yes, mo/day/yrs sample was submitted
Water Well Disinfected? Yes X No

5 TYPE OF BLANK CASING USED: 1 Steel 2 PVC 3 RMP (SR) 4 ABS 5 Wrought iron 6 Asbestos-Cement 7 Fiberglass 8 Concrete tile 9 Other (specify below)
CASING JOINTS: Glued X Clamped Welded Threaded
Blank casing diameter 6 in. to 110 ft., Dia 6" in. to 130-330 ft., Dia in. to ft.
Casing height above land surface 12" in., weight lbs./ft. Wall thickness or guage No. SDR26

TYPE OF SCREEN OR PERFORATION MATERIAL: 1 Steel 2 Brass 3 Stainless Steel 4 Galvanized Steel 5 Fiberglass 6 Concrete tile 7 PVC 8 RMP (SR) 9 ABS 10 Asbestos-Cement 11 Other (Specify) 12 None used (open hole)

SCREEN OR PERFORATION OPENINGS ARE: 1 Continuous slot 2 Louvered shutter 3 Mill slot 4 Key punched 5 Guazed wrapped 6 Wire wrapped 7 Torch cut 8 Saw cut 9 Drilled holes 10 Other (specify) 11 None (open hole)

SCREEN-PERFORATED INTERVALS: From 110 ft. to 130 ft., From 330 ft. to 390 ft.
From ft. to ft., From ft. to ft.
GRAVEL PACK INTERVALS: From 20 ft. to 390 ft., From ft. to ft.
From ft. to ft., From ft. to ft.

6 GROUT MATERIAL: 1 Neat cement 2 Cement grout 3 Bentonite 4 Other
Grout Intervals: From 0 ft. to 20 ft., From ft. to ft., From ft. to ft.

What is the nearest source of possible contamination:
1 Septic tank 2 Sewer lines 3 Watertight sewer lines 4 Lateral lines 5 Cess pool 6 Seepage pit 7 Pit privy 8 Sewage lagoon 9 Feedyard 10 Livestock pens 11 Fuel storage 12 Fertilizer storage 13 Insecticide storage 14 Abandoned water well 15 Oil well/Gas well 16 Other (specify below)
Direction from well? How many feet?

FROM	TO	LITHOLOGIC LOG	FROM	TO	PLUGGING INTERVALS
0	15	Topsoil & clay & little lime	180	187	Clay & little lime
15	30	Clay & little lime (hard)	187	207	Clay
30	45	Clay & little lime (hard)	207	210	Broken Sandstone
45	60	Sand & clay	210	225	Shale (gray & red)
60	70	Sand	225	230	Shale (gray & red)
70	75	Clay	230	240	Shale (gray & red)
75	90	Sand (tight) & little clay	240	255	Shale (hard & little very hard)
90	105	Clay & little lime	255	281	Shale (hard & very hard)
105	120	Clay & little liome	281	283	Rock (very very hard)
120	127	Sand & little clay	283	285	Shale (hard)
127	146	Clay	285	297	Shale & sandstone (very dirty)
146	150	Lime (hard) & clay	297	303	Clay & sandstone (verydirty)
150	165	Clay & little lime	303	315	Clay & sandstone (little dirty)
165	180	Clay & little lime	315	330	Clay & sandstone (little dirty)

7 CONTRACTOR'S OR LANDOWNER'S CERTIFICATION: This water well was (1) constructed, (2) reconstructed, or (3) plugged under my jurisdiction and was completed on (mo/day/year) 1-28-05 and this record is true to the best of my knowledge and belief. Kansas Water Well Contractor's Licence No 223 This Water Well Record was completed on (mo/day/yr) 1-24-05
under the business name of Dunham Drilling Inc. by (signature) Karen Dunham

INSTRUCTIONS: Use typewriter or ball point pen. *PLEASE PRESS FIRMLY* and *PRINT* clearly. Please fill in blanks, underline or circle the correct answers. Send top three copies to Kansas Department of Health and Environment, Bureau of Water, Geology Section, 1000 SW Jackson St., Suite 420, Topeka, Kansas 66612-1367. Telephone 785-296-5522. Send one to WATER WELL OWNER and retain one for your records. Fee of $5.00 for each constructed well.

330	345	Sandstone
345	360	Clay & sandstone (dirty)
360	375	Sandstone (little hard) & little shale
375	390	Sandstone (hard)